


LOCATION OF WATER WELL:	Fraction	Section Number	Township Number	Range Number
County: <u>Reno</u>	<u>NW</u> $\frac{1}{4}$ <u>NW</u> $\frac{1}{4}$ <u>NE</u> $\frac{1}{4}$	<u>10</u>	T <u>23</u> S	R <u>6</u> E <u>W</u>

Distance and direction from nearest town or city street address of well if located within city?

2 WATER WELL OWNER: Shears Inc.
RR#, St. Address, Box # : P.O. Box 1605
City, State, ZIP Code : Hutchinson, KS 67504-1605

Board of Agriculture, Division of Water Resources
Application Number: 960364

3 LOCATE WELL'S LOCATION WITH AN "X" IN SECTION BOX: 4 DEPTH OF COMPLETED WELL: 40 ft. ELEVATION:

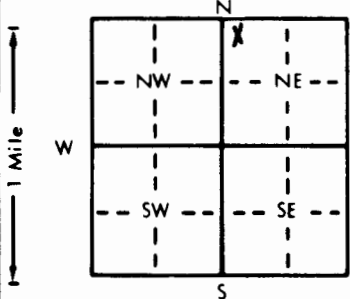

4 DEPTH OF COMPLETED WELL 40 ft. ELEVATION: _____
 Depth(s) Groundwater Encountered 1. _____ ft. 2. _____ ft. 3. _____ ft.
 WELL'S STATIC WATER LEVEL 6 ft. below land surface measured on mo/day/yr 1-8-97
 Pump test data: Well water was _____ ft. after _____ hours pumping _____ gpm
 Est. Yield _____ gpm: Well water was _____ ft. after _____ hours pumping _____ gpm
 Bore Hole Diameter 30 in. to 40 ft., and _____ in. to _____ ft.
 WELL WATER TO BE USED AS:
 1 Domestic 3 Feedlot 6 Oil field water supply 9 Dewatering 11 Injection well
 2 Irrigation 4 Industrial 7 Lawn and garden only 10 Monitoring well 12 Other (Specify below) _____
 Was a chemical/bacteriological sample submitted to Department? Yes _____ No X If yes, mo/day/yr sample was sub-
 mitted _____ Water Well Disinfected? Yes X No _____

5	TYPE OF BLANK CASING USED:	5 Wrought iron	8 Concrete tile	CASING JOINTS: Glued <input checked="" type="checkbox"/> Clamped <input type="checkbox"/>
	1 Steel	6 Asbestos-Cement	9 Other (specify below)	Welded <input type="checkbox"/>
	3 RMP (SR)	7 Fiberglass		Threaded <input type="checkbox"/>
	2 PVC			
	4 ABS			

Blank casing diameter 16 in. to 20 ft. Dia. _____ in. to _____ ft. Dia. _____ in. to _____ ft.
Casing height above land surface 12 in. weight SBR 26 lbs./ft. Wall thickness or gauge No. 3/4"

TYPE OF SCREEN OR PERFORATION MATERIAL:

1 Steel	3 Stainless steel	5 Fiberglass	7 PVC	10 Asbestos-cement
2 Brass	4 Galvanized steel	6 Concrete tile	8 RMP (SR)	11 Other (specify)
			9 ABS	12 None used (open hole)

SCREEN OR PERFORATION OPENINGS ARE:

1 Continuous slot	3 Mill slot	5 Gauzed wrapped	8 Saw cut	11 None (open hole)
2 Louvered shutter	4 Key punched	6 Wire wrapped	9 Drilled holes	
		7 Torch cut	10 Other (specify)	

SCREEN-PERFORATED INTERVALS:	From	20	ft. to	40	ft. From		ft. to		ft.
	From		ft. to		ft. From		ft. to		ft.
GRAVEL PACK INTERVALS:	From	40	ft. to	0	ft. From		ft. to		ft.
	From		ft. to		ft. From		ft. to		ft.

From		ft. to		ft. from		ft. to	
6	GROUT MATERIAL:	1 Neat cement	2 Cement grout	3 Bentonite	4 Other	NONE	
	Grout Interval: From	N/A	ft. to	ft. to	ft. to	ft. to	ft. to

What is the nearest source of possible contamination:		10 Livestock pens	14 Abandoned water well
1 Septic tank	4 Lateral lines	11 Fuel storage	15 Oil well/Gas well
2 Sewer lines	5 Cess pool	12 Fertilizer storage	16 Other (specify below)
3 Watertight sewer lines	6 Seepage pit	9 Feedyard	13 Insecticide storage

Direction from well?				How many feet?		
FROM	TO	LITHOLOGIC LOG	FROM	TO	PLUGGING INTERVALS	
					<i>NONE</i>	

[illegible]

7 CONTRACTOR'S OR LANDOWNER'S CERTIFICATION: This water well was (1) constructed, (2) reconstructed, or (3) plugged under my jurisdiction and was completed on (mo/day/year) ~~10-18-96~~ 11-18-96 and this record is true to the best of my knowledge and belief. Kansas Water Well Contractor's License No. 134 This Water Well Record was completed on (mo/day/yr) 2-15-97 under the business name of Rosencrantz-Bemis Ent Inc by (signature) Doug Dodson