

1) LOCATION OF WATER WELL:		Fraction			Section Number		Township Number			Range Number		
County: Reno		NW ¼ SW ¼ SW ¼			24		T 23 S			R 6 E/W		

1) LOCATION OF WATER WELL:		Fraction			Section Number		Township Number			Range Number		
County: Reno		NW ¼ SW ¼ SW ¼			24		T 23 S			R 6 E/W		

Distance and direction from nearest town or city street address of well if located within city?

48 State Street; S. Hutchinson, KS

2 WATER WELL OWNER: Foodbrands America, Inc.		Board of Agriculture, Division of Water Resources Application Number:
RR#, St. Address, Box #	: 1601 NW Expressway, Ste. 1700	
City, State, ZIP Code	: Oklahoma City, Oklahoma 73118	

3 LOCATE WELL'S LOCATION WITH AN "X" IN SECTION BOX:

1 Mile

W E

N S

NW NE SW SE

X

4 DEPTH OF COMPLETED WELL 13.5 ft. **ELEVATION:** 1526.6

Depth(s) Groundwater Encountered 1. 7.5 ft. 2. ft. 3. ft.

WELL'S STATIC WATER LEVEL 7.13 ft. below land surface measured on mo/day/yr 11/18/98

Pump test data: Well water was NA ft. after hours pumping gpm

Est. Yield NA gpm: Well water was ft. after hours pumping gpm


Bore Hole Diameter 8 in. to 14 ft., and in. to ft.

WELL WATER TO BE USED AS:

5 Public water supply	8 Air conditioning	11 Injection well
1 Domestic	3 Feedlot	6 Oil field water supply
2 Irrigation	4 Industrial	7 Lawn and garden only
		10 Monitoring well
8 Dewatering		
12 Other (Specify below)		

Was a chemical/bacteriological sample submitted to Department? Yes No; If yes, mo/day/yr sample submitted

Water Well Disinfected? Yes No

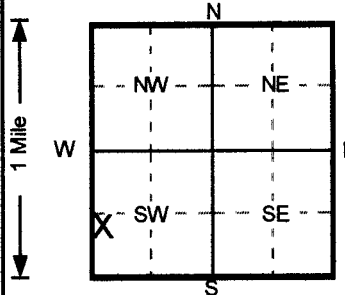

5 TYPE OF BLANK CASING USED:

1 Steel	3 RMP (SR)	5 Wrought iron	8 Concrete tile	CASING JOINTS: Glued	Clamped
2 PVC	4 ABS	6 Asbestos-Cement	9 Other (specify below)	Welded	
		7 Fiberglass		Threaded	✓

Blank casing diameter 2 in. to 3.5 ft., Dia in. to ft., Dia in. to ft.

Casing height above land surface 5.52 in., weight lbs./ft. Wall thickness or gauge No. Sch. 40

TYPE OF SCREEN OR PERFORATION MATERIAL

1 Steel	3 Stainless steel	5 Fiberglass	7 PVC	10 Asbestos-cement
2 Brass	4 Galvanized steel	6 Concrete tile	8 RMP (SR)	11 Other (specify)
			9 ABS	12 None used (open hole)

SCREEN OR PERFORATION OPENINGS ARE:

1 Continuous slot	3 Mill slot	5 Gauzed wrapped	8 Saw cut	11 None (open hole)
2 Louvered shutter	4 Key punched	6 Wire wrapped	9 Drilled holes	
		7 Torch cut	10 Other (specify)	

SCREEN-PERFORATED INTERVALS: From 3.5 ft. to 13.5 ft., From ft. to ft., From ft. to ft.

GRAVEL PACK INTERVALS: From 2.5 ft. to 14 ft., From ft. to ft., From ft. to ft.

6 GROUT MATERIAL: 1 Neat cement 2 Cement grout 3 Bentonite 4 Other
Grout Intervals: From 0 ft. to 1.5 ft., From 1.5 ft. to 2.5 ft., From ft. to ft.
What is the nearest source of possible contamination:
1 Septic tank 4 Lateral lines 7 Pit privy 10 Livestock pens 14 Abandoned water well
2 Sewer lines 5 Cess pool 8 Sewage lagoon 11 Fuel storage 15 Oil well/Gas well
3 Watertight sewer lines 6 Seepage pit 9 Feedyard 12 Fertilizer storage 16 Other (specify below)
Direction from well? In Basin 13 Insecticide storage . . . Former UST Basin . . .
How many feet? 0

FROM	TO	LITHOLOGIC LOG	FROM	TO	PLUGGING INTERVALS
0	0.5	Sand/Clay, Brown			
0.5	4	Clay, Brown			
4	6	Sand, Orange/Brown			
6	8	Sand, Buff			
8	10	Sand, Gray			
10	14	Sand, Tan Brown			
					MW-26 , Tag # 00282314 , Flushmount
					Project Name: King Oil
					GeoCore # 613 , KDHE # U2 078 10286

7 CONTRACTOR'S OR LANDOWNER'S CERTIFICATION: This water well was (1) constructed, (2) reconstructed, or (3) plugged under my jurisdiction and was completed on (mo/day/year) 11/16/98 and this record is true to the best of my knowledge and belief.
Kansas Water Well Contractor's License No. 527 This Water Well Record was completed on (mo/day/yr) 12/2/98
under the business name of GeoCore Services, Inc. by (signature) [Signature]