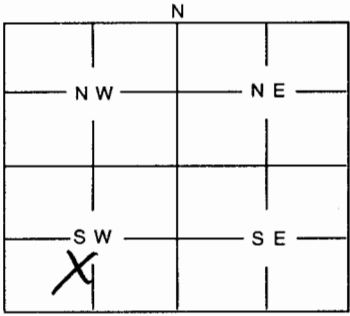


1	LOCATION OF WATER WELL:	Fraction	Section Number	Township Number	Range Number																								
	County: <u>Reno</u>	<u>NE 1/4 SW 1/4 SW 1/4</u>	<u>12</u>	<u>23</u>	<u>66</u>																								
Distance and direction from nearest town or city street address of well if located within city? <u>216 W 19th in Hutchinson</u>																													
2	WATER WELL OWNER: <u>REIB</u>																												
	RR #, St. Address, Box #: <u>201 E 2nd</u>		Board of Agriculture, Division of Water Resources																										
	City, State, ZIP Code: <u>Hutch, KS 67501</u>		Application Number: _____																										
3	MARK WELL'S LOCATION WITH AN "X" IN SECTION BOX:  <table border="1" style="width:100%; text-align: center; border-collapse: collapse;"> <tr><td colspan="2">N</td></tr> <tr><td>NW</td><td>NE</td></tr> <tr><td>SW</td><td>SE</td></tr> <tr><td colspan="2">S</td></tr> </table> 					N		NW	NE	SW	SE	S																	
N																													
NW	NE																												
SW	SE																												
S																													
4	DEPTH OF WELL ..... <u>34</u> ..... ft WELL'S STATIC WATER LEVEL ..... <u>16</u> ..... ft. WELL WAS USED AS: <table style="width:100%;"> <tr> <td>1 Domestic</td> <td>5 Public Water Supply</td> <td>9 Dewatering</td> </tr> <tr> <td>2 Irrigation</td> <td>6 Oil Field Water Supply</td> <td>10 Monitoring Well</td> </tr> <tr> <td>3 Feedlot</td> <td><input checked="" type="checkbox"/> 7 Domestic (Lawn &amp; Garden)</td> <td>11 Injection Well</td> </tr> <tr> <td>4 Industrial</td> <td>8 Air Conditioning</td> <td>12 Other .....</td> </tr> </table> Was a chemical / bacteriological sample submitted to Department? Yes ..... No <input checked="" type="checkbox"/> ..... If yes, mo/day/yr sample was submitted ..... Water Well Disinfected: Yes <input checked="" type="checkbox"/> ..... No .....					1 Domestic	5 Public Water Supply	9 Dewatering	2 Irrigation	6 Oil Field Water Supply	10 Monitoring Well	3 Feedlot	<input checked="" type="checkbox"/> 7 Domestic (Lawn & Garden)	11 Injection Well	4 Industrial	8 Air Conditioning	12 Other .....												
1 Domestic	5 Public Water Supply	9 Dewatering																											
2 Irrigation	6 Oil Field Water Supply	10 Monitoring Well																											
3 Feedlot	<input checked="" type="checkbox"/> 7 Domestic (Lawn & Garden)	11 Injection Well																											
4 Industrial	8 Air Conditioning	12 Other .....																											
5	TYPE OF BLANK CASING USED: 1 Steel <input checked="" type="checkbox"/> RMP (SR)    5 Wrought    7 Fiberglass    9 Other (Specify below) 2 PVC    4 ABS    6 Asbestos-Cement    8 Concrete Tile ..... Blank casing diameter <u>6</u> in.    Was casing pulled? Yes ..... No <input checked="" type="checkbox"/> ..... If yes, how much ..... Casing height above or below land surface ..... <u>36</u> ..... in.																												
6	GROUT PLUG MATERIAL:    1 Neat cement    2 Cement grout <input checked="" type="checkbox"/> 3 Bentonite    4 Other ..... Grout Plug Intervals:    From <u>3</u> ft. to <u>16</u> ft.,    From ..... ft. to ..... ft.,    From ..... to ..... ft. What is the nearest source of possible contamination: <table style="width:100%;"> <tr> <td>1 Septic tank</td> <td>6 Seepage pit</td> <td>11 Fuel storage</td> <td>16 Other (specify below)</td> </tr> <tr> <td>2 Sewer lines</td> <td>7 Pit privy</td> <td>12 Fertilizer storage</td> <td></td> </tr> <tr> <td><input checked="" type="checkbox"/> 3 Watertight sewer lines</td> <td>8 Sewage lagoon</td> <td>13 Insecticide storage</td> <td></td> </tr> <tr> <td>4 Lateral lines</td> <td>9 Feedyard</td> <td>14 Abandoned water well</td> <td></td> </tr> <tr> <td>5 Cess Pool</td> <td>10 Livestock pens</td> <td>15 Oil well/Gas well</td> <td></td> </tr> </table> Direction from well? <u>W</u> .....    How many feet? <u>20</u> .....					1 Septic tank	6 Seepage pit	11 Fuel storage	16 Other (specify below)	2 Sewer lines	7 Pit privy	12 Fertilizer storage		<input checked="" type="checkbox"/> 3 Watertight sewer lines	8 Sewage lagoon	13 Insecticide storage		4 Lateral lines	9 Feedyard	14 Abandoned water well		5 Cess Pool	10 Livestock pens	15 Oil well/Gas well					
1 Septic tank	6 Seepage pit	11 Fuel storage	16 Other (specify below)																										
2 Sewer lines	7 Pit privy	12 Fertilizer storage																											
<input checked="" type="checkbox"/> 3 Watertight sewer lines	8 Sewage lagoon	13 Insecticide storage																											
4 Lateral lines	9 Feedyard	14 Abandoned water well																											
5 Cess Pool	10 Livestock pens	15 Oil well/Gas well																											
<table border="1" style="width:100%; border-collapse: collapse;"> <thead> <tr> <th style="width:15%;">FROM</th> <th style="width:15%;">TO</th> <th style="width:70%;">PLUGGING MATERIALS</th> </tr> </thead> <tbody> <tr> <td><u>3</u></td> <td><u>16</u></td> <td><u>Bentonite</u></td> </tr> <tr> <td><u>16</u></td> <td><u>34</u></td> <td><u>Sand &amp; Gravel</u></td> </tr> <tr><td> </td><td> </td><td> </td></tr> <tr><td> </td><td> </td><td> </td></tr> <tr><td> </td><td> </td><td> </td></tr> <tr><td> </td><td> </td><td> </td></tr> <tr><td> </td><td> </td><td> </td></tr> </tbody> </table>						FROM	TO	PLUGGING MATERIALS	<u>3</u>	<u>16</u>	<u>Bentonite</u>	<u>16</u>	<u>34</u>	<u>Sand &amp; Gravel</u>															
FROM	TO	PLUGGING MATERIALS																											
<u>3</u>	<u>16</u>	<u>Bentonite</u>																											
<u>16</u>	<u>34</u>	<u>Sand &amp; Gravel</u>																											
7	CONTRACTOR'S OR LANDOWNER'S CERTIFICATION: This water well was plugged under my jurisdiction and was completed on (mo/day/year) <u>8-26-04</u> and this record is true to the best of my knowledge and belief. Kansas Water Well Contractor's License No. <u>447</u> This Water Well Record was completed on (mo/day/year) <u>8-26-04</u> under the business name of <u>Miller Drilling</u> by (signature) <u>[Signature]</u>																												
INSTRUCTIONS: Use typewriter or ball point pen. Please press firmly and print clearly. Please fill in blanks, underline or circle the correct answers. Send top three copies to Kansas Department of Health and Environment, Bureau of Water, Topeka, Kansas 66620-0001. Telephone: 785/296-3565. Send one to Water Well Owner and retain one for your records.																													

RECEIVED

OCT 26 2004

BUREAU OF WATER