

1	LOCATION OF WATER WELL:	Fraction	Section Number	Township Number	Range Number
County:	Reno	SW $\frac{1}{4}$ SW $\frac{1}{4}$ SW $\frac{1}{4}$	24	T 23 S	R 6 EW

Distance and direction from nearest town or city street address of well if located within city?

3 N. Main

2 WATER WELL OWNER: Kwik Shop #768

RR#, St. Address, Box # : 202 N. Main
City, State, ZIP Code : Hutchinson, KS 67505


Board

Board of Agriculture, Division of Water Resources

Application Number:

3	LOCATE WELL'S LOCATION WITH	4	DEPTH OF COMPLETED WELL 4.5 ft. ELEVATION:
---	-----------------------------	---	--

AN "X" IN SECTION BOX:

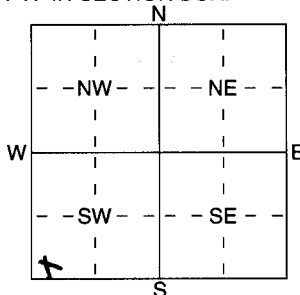

Depth(s) Groundwater Encountered 1. _____ ft. 2. _____ ft. 3. _____ ft.
WELL'S STATIC WATER LEVEL 8.58 ft. below land surface measured on mo/day/yr 2/21/05
Pump test data: Well water was _____ ft. after _____ hours pumping _____ gpm
Est. Yield _____ gpm: Well water was _____ ft. after _____ hours pumping _____ gpm
WELL WATER TO BE USED AS: 5 Public water supply 8 Air conditioning 11 Injection well
1 Domestic 3 Feedlot 6 Oil field water supply 9 Dewatering 12 Other (Specify below)
2 Irrigation 4 Industrial 7 Domestic (lawn & garden) 10 Monitoring well

Was a chemical/bacteriological sample submitted to Department? Yes No ; If yes, mo/day/yr sample was submitted

Water Well Disinfected? Yes No

5	TYPE OF BLANK CASING USED:
---	----------------------------

1 Steel
2 PVC
3 RMP (SR)
4 ABS

5 Wrought iron
6 Asbestos-Cement
7 Fiberglass

8 Concrete tile
9 Other (specify below)

CASING JOINTS: Glued Clamped

Welded
Threaded

Blank casing diameter 2 in. to 10 ft., Dia _____ in. to _____ ft., Dia _____ in. to _____ ft.

Casing height above land surface in., weight lbs./ft. Wall thickness or gauge No.

TYPE OF SCREEN OR PERFORATION MATERIAL:

1 Steel	3 Stainless Steel	5 Fiberglass
2 Brass	4 Galvanized Steel	6 Concrete tile

7 PVC

10 Asbestos-Cement

11 Other (Specify)

12 None used (open hole)

SCREEN OR PERFORATION OPENINGS ARE:

1 Continuous slot
2 Louvered shutter
3 ☒ Mill slot
4 Key punched

5 Guazed wrapped
6 Wire wrapped
7 Torch cut

8 Saw cut
9 Drilled holes
10 Other (specify)
11 None (open hole)

SCREEN-PERFORATED INTERVALS: From 4.5 ft. to 14.5 ft., From _____ ft. to _____ ft.

GRAVEL PACK INTERVALS: From 3 ft. to 14.5 ft. From ft. to ft.
From ft. to ft. From ft. to ft.

6	GROUT MATERIAL:	1 Neat cement	2 Cement grout	3 Bentonite
---	-----------------	---------------	----------------	-------------

Grout Intervals: From ft. to ft., From ft. to ft., From ft. to ft.

What is the nearest source of possible contamination:

1 Septic tank	4 Lateral lines	7 Pit privy	11 Fuel storage	15 Oil well/Gas well
2 Sewer lines	5 Cess pool	8 Sewage lagoon	12 Fertilizer storage	16 Other (specify below)
3 Watertight sewer lines	6 Seepage pit	9 Feedyard	13 Insecticide storage

Direction from well?

How many feet?

[illegible]

Flushmount waiver
by D. Taylor

7. CONTRACTOR'S OR LANDOWNER'S CERTIFICATION: This water well was (1) constructed, (2) reconstructed, or (3) plugged under my jurisdiction and was completed on (mo/day/year) 2/14/03 and this record is true to the best of my knowledge and belief. Kansas

Water Well Contractor's Licence No. 1757 This Water Well Record was completed on (mo/day/yr) 3/14/03
under the business name of Larsen Associates Inc. by (signature) Vicki Mann