


1 LOCATION OF WATER WELL:		Fraction		Section Number		Township Number		Range Number	
County:	Reno	SW ¼	NW ¼	SW ¼	22	T	23 S	R	6 EW

1910 S. Broadacres Road, Hutchinson

Application Number:

submitted Water Well Disinfected? Yes No ☒

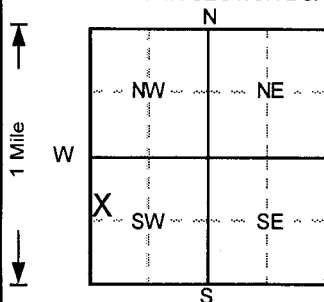

How many feet? 0

FROM	TO	LITHOLOGIC LOG	FROM	TO	PLUGGING INTERVALS
0	2	Clay, silty, sandy (topsoil), Dark Brown			
3	25	Clay and Sand, moist, stiff to sl. plasticity, Tan			
21	33	Sand (f-c), tr. fine gravel, Tan			
					MW4S , Abovegrade
					Project Name: GeoStat - Koch - Hutchinson
					GeoCore # 1229 , #

INSTRUCTIONS: Use typewriter or ball point pen. PLEASE PRESS FIRMLY and PRINT clearly. Please fill in blanks, underline or circle the correct answers. Send top three copies to Kansas Department of Health and Environment, Bureau of Water, Topeka, Kansas 66620-0001. Telephone: 913-296-5545. Send one to WATER WELL OWNER and retain one for your records.