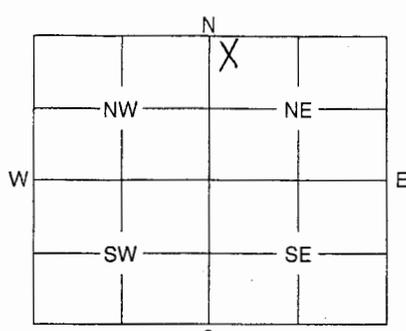


1	LOCATION OF WATER WELL:	Fraction	Section Number	Township Number	Range Number
	County: Reno	NW ¼ NW ¼ NE ¼	28	23 S	6 E/W

Distance and direction from nearest town or city street address of well if located within city?
1910 S. Broadacres Road, Hutchinson

2	WATER WELL OWNER: Koch Underground Storage	Board of Agriculture, Division of Water Resources
	RR #, St. Address, Box #: 1910 S. Broadacres Road	Application Number:
	City, State, ZIP Code: Hutchinson, KS 67501	

3	MARK WELL'S LOCATION WITH AN "X" IN SECTION BOX:	4	DEPTH OF WELL 210.2 ft.
		WELL'S STATIC WATER LEVEL 47 ft.	
		WELL WAS USED AS:	
		1 Domestic	5 Public Water Supply
		2 Irrigation	6 Oil Field Water Supply
		3 Feedlot	7 Domestic (Lawn & Garden)
		4 Industrial	8 Air Conditioning
			9 Dewatering
			10 Monitoring Well
			11 Injection Well
			12 Other

Was a chemical / bacteriological sample submitted to Department? Yes No **..X..**
 If yes, mo/day/yr sample was submitted

Water Well Disinfected: Yes No **..X..**

5	TYPE OF BLANK CASING USED:
	1 Steel 3 RMP (SR) 5 Wrought 7 Fiberglass 9 Other (Specify below) 2 PVC 4 ABS 6 Asbestos-Cement 8 Concrete Tile
	Blank casing diameter 4 in. Was casing pulled? Yes <input checked="" type="checkbox"/> No If yes, how much 3'
	Casing height above or below land surface N/A in.

6	GROUT PLUG MATERIAL:	1 Neat cement	2 Cement grout	3 Bentonite	4 Other Native Soil
	Grout Plug Intervals:	From 0 ft.	to 3 ft.,	From 3 ft.	to 210.2 ft.,
	What is the nearest source of possible contamination:				
	1 Septic tank	6 Seepage pit	11 Fuel storage	16 Other (specify below)	
	2 Sewer lines	7 Pit privy	12 Fertilizer storage		
	3 Watertight sewer lines	8 Sewage lagoon	13 Insecticide storage		
	4 Lateral lines	9 Feedyard	14 Abandoned water well		
	5 Cess pool	10 Livestock pens	15 Oil well/Gas well		
	Direction from well? How many feet?				

FROM	TO	PLUGGING MATERIALS
0	3	Native soil (11")
3	47	Bentonite (11")
47	210.2	Bentonite (4")

Hi-04

7	CONTRACTOR'S OF LANDOWNER'S CERTIFICATION: This water well was plugged under my jurisdiction and was completed on (mo/day/year) 01/24/2005 and this record is true to the best of my knowledge and belief. Kansas Water Well Contractor's License No. 527 This Water Well Record was completed on (mo/day/year) 6/29/2005 under the business name of GeoCore, Inc. by (signature) <i>[Signature]</i>
---	--

INSTRUCTIONS: Use typewriter or ball point pen. Please press firmly and print clearly. Please fill in blanks, underline or circle the correct answers. Send top three copies to Kansas Department of Health and Environment, Bureau of Water, Geology Section, 1000 SW Jackson St., Ste. 420, Topeka, Kansas 66612-1367. Telephone: 785/296-5522. Send one to Water Well Owner and retain one for your records.