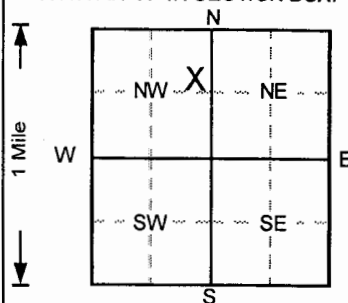


1 LOCATION OF WATER WELL:	Fraction	Section Number	Township Number	Range Number
County: Reno	SE ¼ NE ¼ NW ¼	28	T 23 S	R 6 E/W

Distance and direction from nearest town or city street address of well if located within city?

1910 S. Broadacres Road, Hutchinson2 WATER WELL OWNER: **Koch Underground Storage**RR#, St. Address, Box # : **1910 S. Broadacres Road**City, State, ZIP Code : **Hutchinson, KS 67501**Board of Agriculture, Division of Water Resources
Application Number:

3 LOCATE WELL'S LOCATION WITH AN "X" IN SECTION BOX:

4 DEPTH OF COMPLETED WELL: **200** ft. ELEVATION: **0**Depth(s) Groundwater Encountered 1. **1** ft. 2. **1** ft. 3. **1** ft.WELL'S STATIC WATER LEVEL: **39.66** ft. below land surface measured on mo/day/yr **6/29/2005**Pump test data: Well water was **NA** ft. after **NA** hours pumping **NA** gpmEst. Yield **NA** gpm: Well water was **NA** ft. after **NA** hours pumping **NA** gpmBore Hole Diameter **7** in. to **200** ft. and **NA** in. to **NA** ft.

WELL WATER TO BE USED AS: 5 Public water supply 8 Air conditioning 11 Injection well

1 Domestic 3 Feedlot 6 Oil field water supply 9 Dewatering 12 Other (Specify below)

2 Irrigation 4 Industrial 7 Lawn and garden only **10** Monitoring wellWas a chemical/bacteriological sample submitted to Department? Yes **No** ✓; If yes, mo/day/yr sample was submitted Water Well Disinfected? Yes **No** ✓

5 TYPE OF BLANK CASING USED:

1 Steel 3 RMP (SR) 5 Wrought iron 8 Concrete tile CASING JOINTS: Glued **Clamped****2** PVC 4 ABS 6 Asbestos-Cement 9 Other (specify below) Welded **Threaded** ✓Blank casing diameter **2** in. to **165** ft. Dia **NA** in. to **NA** ft. Dia **NA** in. to **NA** ft.Casing height above land surface **30** in. weight **NA** lbs./ft. Wall thickness or gauge No. **Sch. 40**

TYPE OF SCREEN OR PERFORATION MATERIAL

1 Steel 3 Stainless steel 5 Fiberglass **7** PVC 10 Asbestos-cement

2 Brass 4 Galvanized steel 6 Concrete tile 8 RMP (SR) 11 Other (specify)

SCREEN OR PERFORATION OPENINGS ARE: 5 Gauzed wrapped 8 Saw cut 11 None (open hole)

1 Continuous slot **3** Mill slot 6 Wire wrapped 9 Drilled holes

2 Louvered shutter 4 Key punched 7 Torch cut 10 Other (specify)

SCREEN-PERFORATED INTERVALS: From **165** ft. to **200** ft. From **NA** ft. to **NA** ft.From **NA** ft. to **NA** ft. From **NA** ft. to **NA** ft.GRAVEL PACK INTERVALS: From **160** ft. to **200** ft. From **NA** ft. to **NA** ft.From **NA** ft. to **NA** ft. From **NA** ft. to **NA** ft.

6 GROUT MATERIAL:

1 Neat cement 2 Cement grout **3** Bentonite 4 OtherGrout intervals: From **0** ft. to **158** ft. From **158** ft. to **160** ft. From **NA** ft. to **NA** ft.

What is the nearest source of possible contamination:

1 Septic tank 4 Lateral lines 7 Pit privy 10 Livestock pens 14 Abandoned water well

2 Sewer lines 5 Cess pool 8 Sewage lagoon 11 Fuel storage 15 Oil well/Gas well

3 Watertight sewer lines 6 Seepage pit 9 Feedyard 12 Fertilizer storage 16 Other (specify below)

Direction from well?

How many feet? **0**

FROM	TO	LITHOLOGIC LOG	FROM	TO	PLUGGING INTERVALS
0	2	Topsoil, sandy, Brown			
2	25	Clay, silty, Brown			
20	50	Sand (f-m), some clay, silty,			
50	60	Sand (f-m), some caliche, Tan			
60	70	Sand (m), well sorted			
70	80	Sand (f-c), gravel, some clay, Lt. Tan			
80	100	Sand (m-c), fair sorting,			
100	110	Gravel and Sand (m-c), fair sorting,			
110	120	Gravel and Sand (m-c), fair sorting,			
120	130	Gravel and Sand (m-c), fair sorting, with clay,			
130	140	Sand (m), fair to good sorting,			
140	150	Gravel and Sand (m-c), poor sorting,			
150	175	Sand (f-m), fair sorting,			MW17D, Abovegrade
175	180	Shale, some sand cavings, Green			Project Name: GeoStat - Koch - Hutchinson
180	200	Shale, hard, some sand cavings, Green to Red,			GeoCore # 1229, #

7 CONTRACTOR'S OR LANDOWNER'S CERTIFICATION: This water well was **(1)** constructed, (2) reconstructed, or (3) plugged under my jurisdiction and was completed on (mo/day/year) **6/16/2005** and this record is true to the best of my knowledge and belief.

Kansas Water Well Contractor's License No. **527** This Water Well Record was completed on (mo/day/yr) **6-30-05**

under the business name of **GeoCore, Inc.** by (signature) *Dale Kohl*