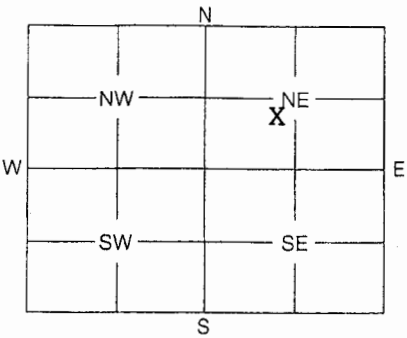


1	LOCATION OF WATER WELL:	Fraction	Section Number	Township Number	Range Number
County:	Reno	NE ¼ SW ¼ NE ¼	29	23 S	6

Distance and direction from nearest town or city street address of well if located within city?

2610 S. Mohawk Rd., So. Hutchinson

2	WATER WELL OWNER: Ferrellgas
RR #, St. Address, Box #:	2610 S. Mohawk Rd.
City, State, ZIP Code:	So. Hutchinson, KS 67505
	Board of Agriculture, Division of Water Resources Application Number:

3	MARK WELL'S LOCATION WITH AN "X" IN SECTION BOX:	4	DEPTH OF WELL 55.9 ft.
		WELL'S STATIC WATER LEVEL 45.36 ft. WELL WAS USED AS: 1 Domestic 5 Public Water Supply 9 Dewatering 2 Irrigation 6 Oil Field Water Supply 10 Monitoring Well 3 Feedlot 7 Domestic (Lawn & Garden) 11 Injection Well 4 Industrial 8 Air Conditioning 12 Other	
		Was a chemical / bacteriological sample submitted to Department? Yes No <u>X</u> If yes, mo/day/yr sample was submitted Water Well Disinfected: Yes No <u>X</u>	

5	TYPE OF BLANK CASING USED:
1 Steel 3 RMP (SR) 5 Wrought 7 Fiberglass 9 Other (Specify below) <u>2</u> PVC 4 ABS 6 Asbestos-Cement 8 Concrete Tile	
Blank casing diameter 2 in. Was casing pulled? Yes <u>X</u> No If yes, how much 3' Casing height above or below land surface n/a in.	

6	GROUT PLUG MATERIAL:	1 Neat cement	2 Cement grout	<u>3</u> Bentonite	<u>4</u> Other Native soil
Grout Plug Intervals: From 0 ft. to 0.5 ft., From 0.5 ft. to 55 ft., From to ft.					
What is the nearest source of possible contamination:					
1 Septic tank 6 Seepage pit 11 Fuel storage 16 Other (specify below) Brine pond 2 Sewer lines 7 Pit privy 12 Fertilizer storage 3 Watertight sewer lines 8 Sewage lagoon 13 Insecticide storage 4 Lateral lines 9 Feedyard 14 Abandoned water well 5 Cess pool 10 Livestock pens 15 Oil well/Gas well					
Direction from well? How many feet?					

FROM	TO	PLUGGING MATERIALS
0	0.5	Native soil (8")
0.5	3	Bentonite (8")
3	55	Bentonite (2")

MW18

GeoCore #1160

7	CONTRACTOR'S OF LANDOWNER'S CERTIFICATION: This water well was plugged under my jurisdiction and was completed on (mo/day/year) 7/29/2005 and this record is true to the best of my knowledge and belief. Kansas Water Well Contractor's License No. 527 This Water Well Record was completed on (mo/day/year) 8/2/2005 under the business name of GeoCore, Inc.
	by (signature) <i>Don Hall</i>

INSTRUCTIONS: Use typewriter or ball point pen. Please press firmly and print clearly. Please fill in blanks, underline or circle the correct answers. Send top three copies to Kansas Department of Health and Environment, Bureau of Water, Geology Section, 1000 SW Jackson St., Ste. 420, Topeka, Kansas 66612-1367. Telephone: 785/296-5522. Send one to Water Well Owner and retain one for your records.