

1 LOCATION OF WATER WELL: County: Reno Fraction: SE 1/4 Section Number: 8 Township Number: T 23 S Range Number: R 6 EW

Distance and direction from nearest town or city street address of well if located within city?

2 mi west of Hutchinson on 4th Street

2 WATER WELL OWNER: Reno Recreation Inc.

RR#, St. Address, Box # :

City, State, ZIP Code :


4300 W. 4th
Hutchinson Kan 67501

Board of Agriculture, Division of Water Resources

Application Number:

3 LOCATE WELL'S LOCATION WITH AN "X" IN SECTION BOX:

4 DEPTH OF COMPLETED WELL: 25 ft. ELEVATION:

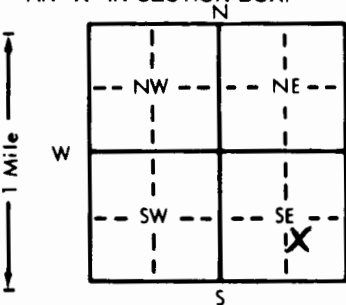

Depth(s) Groundwater Encountered 1. 9 ft. 2. 9 ft. 3. 9 ft.

WELL'S STATIC WATER LEVEL 9 ft. below land surface measured on mo/day/yr 3-17-81

Pump test data: Well water was 11 ft. after 1 hours pumping 60 gpm

Est. Yield 100 gpm: Well water was 11 ft. after 1 hours pumping 60 gpm

Bore Hole Diameter 9 in. to 10 ft. and 6 in. to 25 ft.

WELL WATER TO BE USED AS: ☒ Public water supply 8 Air conditioning 11 Injection well

1 Domestic 3 Feedlot 6 Oil field water supply 9 Dewatering 12 Other (Specify below)

2 Irrigation 4 Industrial 7 Lawn and garden only 10 Observation well

Was a chemical/bacteriological sample submitted to Department? Yes No X; If yes, mo/day/yr sample was submitted

Water Well Disinfected? Yes X No

5 TYPE OF BLANK CASING USED:

5 Wrought iron

8 Concrete tile

CASING JOINTS: Glued X Clamped

1 Steel

3 RMP (SR)

6 Asbestos-Cement

9 Other (specify below)

Welded

☒ PVC

4 ABS

7 Fiberglass

Threaded

Blank casing diameter 6 in. to 19 ft. Dia. 12 in. to 19 ft. Dia. 1255 lbs./ft. Wall thickness or gauge No.

Casing height above land surface 12 in. weight 1255 lbs./ft. Wall thickness or gauge No.

TYPE OF SCREEN OR PERFORATION MATERIAL:

1 Steel

3 Stainless steel

5 Fiberglass

☒ PVC

10 Asbestos-cement

2 Brass

4 Galvanized steel

6 Concrete tile

8 RMP (SR)

11 Other (specify)

9 ABS

12 None used (open hole)

SCREEN OR PERFORATION OPENINGS ARE:

1 Continuous slot

3 Mill slot

5 Gauzed wrapped

8 Saw cut

11 None (open hole)

2 Louvered shutter

4 Key punched

6 Wire wrapped

☒ Drilled holes

7 Torch cut

10 Other (specify)

SCREEN-PERFORATED INTERVALS: From 19 ft. to 25 ft. From 19 ft. to 25 ft.

GRAVEL PACK INTERVALS: From 19 ft. to 25 ft. From 19 ft. to 25 ft.

6 GROUT MATERIAL: ☒ Neat cement 2 Cement grout 3 Bentonite 4 Other

Grout Intervals: From 3 ft. to 10 ft. From 3 ft. to 10 ft.

What is the nearest source of possible contamination:

1 Septic tank

4 Lateral lines

7 Pit privy

10 Livestock pens

14 Abandoned water well

2 Sewer lines

5 Cess pool

8 Sewage lagoon

11 Fuel storage

15 Oil well/Gas well

3 Watertight sewer lines

6 Seepage pit

9 Feedyard

12 Fertilizer storage

☒ Other (specify below)

13 Insecticide storage

old Sand Pit

Direction from well?

South

How many feet? 200

FROM TO LITHOLOGIC LOG FROM TO LITHOLOGIC LOG

0 7 fine gravel
7 25 medium gravel

7 CONTRACTOR'S OR LANDOWNER'S CERTIFICATION: This water well was ☒ constructed, (2) reconstructed, or (3) plugged under my jurisdiction and was completed on (mo/day/year) 3-17-81 and this record is true to the best of my knowledge and belief. Kansas

Water Well Contractor's License No. 193 This Water Well Record was completed on (mo/day/yr) 5-10-82

under the business name of Price Water Well Service by (signature) John Davenport

INSTRUCTIONS: Use typewriter or ball point pen, PLEASE PRESS FIRMLY and PRINT clearly. Please fill in blanks, underline or circle the correct answers. Send top three copies to Kansas Department of Health and Environment, Division of Environment, Environmental Geology Section, Topeka, KS 66620. Send one to WATER WELL OWNER and retain one for your records.

OFFICE USE ONLY

T

R

END

SEC.

8

200

SE 1/4

SE 1/4