**CORRECTION(S) TO WATER WELL RECORD (WWC-5)**
(to rectify lacking or incorrect information)

County: RENO

| **Location listed as:** | **Location ~~changed to~~:** |
|---|---|
| Section-Township-Range: | 12-23-6W |
| Fraction ( ¼ ¼ ¼): | NW SW NE |

**Other changes:** Initial statements:

Changed to:

Comments: WELL CONSTRUCTED ONLY - NOT PLUGGED. COMPLETION DATE JUST PRIOR TO DATE WATER LEVEL MEASURED.

verification method: CALL TO DRILLER

initials: DS date: 3/21/06

submitted by: Kansas Geological Survey, Data Resources Library, 1930 Constant Ave., Lawrence, KS 66047-3726
to: Kansas Dept of Health & Environment, Bureau of Water, 1000 SW Jackson, Suite 420, Topeka, KS 66612-1367.

WATER WELL RECORD Form WWC-5 KSA 82a-1212

1 LOCATION OF WATER WELL: County: Reno | Fraction: NW 1/4 SW 1/4 NE 1/4 | Section Number: 12 | Township Number: T 23 S | Range Number: R 6 E/W

Distance and direction from nearest town or city street address of well if located within city?
1224 Main St S.E. of Building Hutchinson KS

2 WATER WELL OWNER: KDHE
RR#, St. Address, Box # : Forbes Field Bldg 740
City, State, ZIP Code : Topeka KS 66620-0001
Board of Agriculture, Division of Water Resources
Application Number:

3 LOCATE WELL'S LOCATION WITH AN "X" IN SECTION BOX:

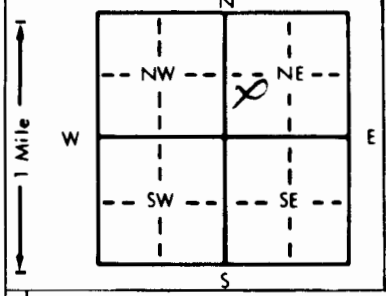


4 DEPTH OF COMPLETED WELL 41.93 ft. ELEVATION: 1535.5
Depth(s) Groundwater Encountered 1. 16.0 ft. 2. — ft. 3. — ft.
WELL'S STATIC WATER LEVEL 16.68 ft. below land surface measured on mo/day/yr 06/04/97
Pump test data: Well water was — ft. after — hours pumping — gpm
Est. Yield — gpm: Well water was — ft. after — hours pumping — gpm
Bore Hole Diameter 13 in. to 42.0 ft., and — in. to — ft.
WELL WATER TO BE USED AS: 5 Public water supply 8 Air conditioning 11 Injection well
1 Domestic 3 Feedlot 6 Oil field water supply 9 Dewatering 12 Other (Specify below)
2 Irrigation 4 Industrial 7 Lawn and garden only 10 Monitoring well AAS-1
Was a chemical/bacteriological sample submitted to Department? Yes ..... No ..... ; If yes, mo/day/yr sample was submitted
Water Well Disinfected? Yes No

5 TYPE OF BLANK CASING USED: 5 Wrought iron 8 Concrete tile CASING JOINTS: Glued ..... Clamped .....
1 Steel 3 RMP (SR) 6 Asbestos-Cement 9 Other (specify below) Welded .....
2 PVC 4 ABS 7 Fiberglass Threaded .....
Blank casing diameter 2 in. to 39 ft., Dia — in. to — ft., Dia — in. to — ft.
Casing height above land surface -0.3 in., weight ..... lbs./ft. Wall thickness or gauge No. .....

TYPE OF SCREEN OR PERFORATION MATERIAL: 7 PVC 10 Asbestos-cement
1 Steel 3 Stainless steel 5 Fiberglass 8 RMP (SR) 11 Other (specify) .....
2 Brass 4 Galvanized steel 6 Concrete tile 9 ABS 12 None used (open hole)

SCREEN OR PERFORATION OPENINGS ARE: 5 Gauzed wrapped 8 Saw cut 11 None (open hole)
1 Continuous slot 3 Mill slot 6 Wire wrapped 9 Drilled holes
2 Louvered shutter 4 Key punched 7 Torch cut 10 Other (specify) .....

SCREEN-PERFORATED INTERVALS: From 41.93 ft. to 38.43 ft., From — ft. to — ft.
From — ft. to — ft., From — ft. to — ft.
GRAVEL PACK INTERVALS: From 42.0 ft. to 40.0 35.0 ft., From — ft. to — ft.
From ft. to ft., From ft. to ft.

6 GROUT MATERIAL: 1 Neat cement 2 Cement grout 3 Bentonite 4 Other .....
Grout Intervals: From 40 35 ft. to 1' ft., From 1' ft. to 0 ft., From ft. to ft.

What is the nearest source of possible contamination:
1 Septic tank 4 Lateral lines 7 Pit privy 10 Livestock pens 14 Abandoned water well
2 Sewer lines 5 Cess pool 8 Sewage lagoon 11 Fuel storage 15 Oil well/Gas well
3 Watertight sewer lines 6 Seepage pit 9 Feedyard 12 Fertilizer storage 16 Other (specify below)
13 Insecticide storage .....
Direction from well? How many feet?

| FROM | TO | LITHOLOGIC LOG | FROM | TO | PLUGGING INTERVALS |
|---|---|---|---|---|---|
| 0 | 3 | Brn Clays | 35.0 | 1.0 | Bentonite |
| 3 | 42 | Gravels & Sands | 1.0 | 0.0 | Cement |
| | | | 42' | 35' | Sands |

7 CONTRACTOR'S OR LANDOWNER'S CERTIFICATION: This water well was (1) constructed, (2) reconstructed, or (3) plugged under my jurisdiction and was completed on (mo/day/year) ..... and this record is true to the best of my knowledge and belief. Kansas Water Well Contractor's License No. 568 This Water Well Record was completed on (mo/day/yr) .....
under the business name of Max5 by (signature) David Hughes

INSTRUCTIONS: Use typewriter or ball point pen. PLEASE PRESS FIRMLY and PRINT clearly. Please fill in blanks, underline or circle the correct answers. Send top three copies to Kansas Department of Health and Environment, Bureau of Water, Topeka, Kansas 66620-0001. Telephone: 913-296-5545. Send one to WATER WELL OWNER and retain one for your records.

OFFICE USE ONLY T R E/W SEC. 1/4 1/4 1/4