

1	LOCATION OF WATER WELL:	Fraction	Section Number	Township Number	Range Number
County:	Reno	NE $\frac{1}{4}$ NW $\frac{1}{4}$ NW $\frac{1}{4}$	15	T 23 S	R 6 E/W

Distance and direction from nearest town or city street address of well if located within city?


2 WATER WELL OWNER: Jim Ellington

RR#, St. Address, Box # : 204 N. Westland Drive
City, State, ZIP Code : Hutchinson, KS 67501

Board of Agriculture, Division of Water Resources
Application Number:

3	LOCATE WELL'S LOCATION WITH	4	DEPTH OF COMPLETED WELL 38 ft. ELEVATION:
---	-----------------------------	---	--

AN "X" IN SECTION BOX:

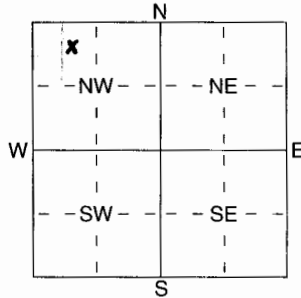

Depth(s) Groundwater Encountered 1 ft. 2 ft. 3 ft.

WELL'S STATIC WATER LEVEL 10 ft. below land surface measured on mo/day/yr 1-31-06

Pump test data: Well water was ft. after hours pumping gpm

Est. Yield gpm: Well water was ft. after hours pumping gpm

WELL WATER TO BE USED AS:

1 Domestic	3 Feedlot	6 Oil field water supply	8 Air conditioning	11 Injection well
2 Irrigation	4 Industrial	7 Domestic (lawn & garden)	9 Dewatering	12 Other (Specify below)
		10 Monitoring well		

Was a chemical/bacteriological sample submitted to Department? Yes No ☒; If yes, mo/day/hrs sample was submitted
Water Well Disinfected? Yes ☒ No

5	TYPE OF BLANK CASING USED:
---	----------------------------

1 Steel	3 RMP (SR)
2 PVC	4 ABS

5 Wrought iron
6 Asbestos-Cement
7 Fiberglass

8 Concrete tile
9 Other (specify below)

CASING JOINTS: Glued Clamped
 Welded
 Threaded

Blank casing diameter 5 in. to 28 ft., Dia _____ in. to _____ ft., Dia _____ in. to _____ ft.

Casing height above land surface 20 in., weight 160# lbs./ft. Wall thickness or guage No. .214

TYPE OF SCREEN OR PERFORATION MATERIAL:

1 Steel	3 Stainless Steel
2 Brass	4 Galvanized Steel

5 Fiberglass
6 Concrete tile

7 PVC
8 RMP (SR)
9 ABS

10 Asbestos-Cement
11 Other (Specify)
12 None used (open hole)

SCREEN OR PERFORATION OPENINGS ARE:

1 Continuous slot	3 Mill slot
2 Louvered shutter	4 Key punched

5 Guazed wrapped
6 Wire wrapped
7 Torch cut

8 Saw cut 11 None (open hole)
9 Drilled holes
10 Other (specify)ft.

SCREEN-PERFORATED INTERVALS: From 28 ft. to 38 ft., From _____ ft. to _____ ft.
From _____ ft. to _____ ft., From _____ ft. to _____ ft.
GRAVEL PACK INTERVALS: From 38 ft. to 12 ft., From _____ ft. to _____ ft.
From _____ ft. to _____ ft., From _____ ft. to _____ ft.

6 GROUT MATERIAL: 1 Neat cement 2 Cement grout 3 Bentonite 4 Other *Wale plug*

Grout Intervals: From *0* ft. to *12* ft. From _____ ft. to _____ ft. From _____ ft. to _____ ft.

What is the nearest source of possible contamination:

1 <u>Septic tank</u>	4 Lateral lines	7 Pit privy	11 Fuel storage	15 Oil well/Gas well
2 Sewer lines	5 Cess pool	8 Sewage lagoon	12 Fertilizer storage	16 Other (specify below)
3 Watertight sewer lines	6 Seepage pit	9 Feedyard	13 Insecticide storage	

Direction from well?

How many feet?

[illegible]

7] CONTRACTOR'S OR LANDOWNER'S CERTIFICATION: This water well was (1) constructed, (2) reconstructed, or (3) plugged under my jurisdiction and was completed on (mo/day/year) 1-31-06 and this record is true to the best of my knowledge and belief. Kansas Water Well Contractor's Licence No. 134 This Water Well Record was completed on (mo/day/yr) 2-10-06 under the business name of Rapier & Bernis Ent. by (signature) Doreen Doolan.