


1 LOCATION OF WATER WELL:	Fraction	Section Number	Township Number	Range Number
County: <u>Rego</u>	<u>SW</u> $\frac{1}{4}$ <u>NE</u> $\frac{1}{4}$ <u>SW</u> $\frac{1}{4}$	<u>29</u>	T <u>23</u> S	R <u>6</u> <u>SW</u>

Distance and direction from nearest town or city street address of well if located within city?

50 HWY 61 LN SW 3/4 Sec 29 W Side

2 WATER WELL OWNER	Board of Agriculture, Division of Water Resources
RR#, St. Address, Box #	Application Number:
City, State, ZIP Code	

3 LOCATE WELL'S LOCATION WITH AN "X" IN SECTION BOX:

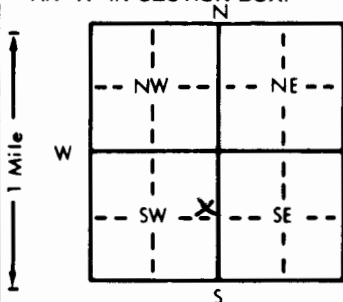

4 DEPTH OF COMPLETED WELL


WELL WATER TO BE USED AS: 5 Public water supply 8 Air conditioning 11 Injection well

1 Domestic 3 Feedlot 6 Oil field water supply 9 Dewatering 12 Other (Specify below)

2 Irrigation 4 Industrial 7 Lawn and garden only 10 Monitoring well

Was a chemical/bacteriological sample submitted to Department? Yes No X; If yes, mo/day/yr sample was submittedWater Well Disinfected? Yes No X

5 TYPE OF BLANK CASING USED:	5 Wrought iron	8 Concrete tile	CASING JOINTS: Glued <u>X</u> Clamped
1 Steel	3 RMP (SR)	6 Asbestos-Cement	9 Other (specify below)
2 PVC	4 ABS	7 Fiberglass	10 Asbestos-cement
Blank casing diameter <u>4</u> in. to <u>58</u> ft., Dia <u>4</u> in. to <u>58</u> ft., Dia <u>4</u> in. to <u>58</u> ft.			11 Other (specify)
Casing height above land surface <u>24</u> in., weight <u>140</u> lbs./ft. Wall thickness or gauge No. <u>140</u>			12 None used (open hole)

TYPE OF SCREEN OR PERFORATION MATERIAL:

1 Steel	3 Stainless steel	5 Fiberglass	7 PVC	10 Asbestos-cement
2 Brass	4 Galvanized steel	6 Concrete tile	8 RMP (SR)	11 Other (specify)
SCREEN OR PERFORATION OPENINGS ARE:	5 Gauzed wrapped	8 Saw cut	11 None (open hole)	
1 Continuous slot	3 Mill slot	9 Drilled holes		
2 Louvered shutter	4 Key punched	10 Other (specify)		

ft. to 68 ft., From 68 ft. to 68 ft., From 68 ft. to 68 ft.7 CONTRACTOR'S OR LANDOWNER'S CERTIFICATION: This water well was (1) constructed, (2) reconstructed, or (3) plugged under my jurisdiction and was completed on (mo/day/year) 2-27-91 and this record is true to the best of my knowledge and belief. KansasWater Contractor's License No. 537 This Water Well Record was completed on (mo/day/yr) 3-10-91under the business name of Hawes Drilling by (signature) Mike Hawes