

1	LOCATION OF WATER WELL:	Fraction	Section Number	Township Number	Range Number
	County: Reno	NW 1/4 NE 1/4 NW 1/4	13	23	6-West

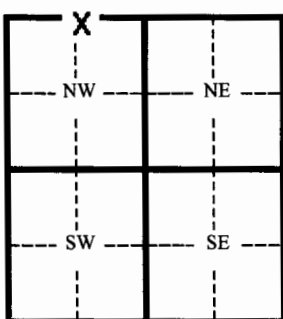
Distance and direction from nearest town or city street address of well if located within city?

125 W. 4th Avenue, Hutchinson, Kansas2 WATER WELL OWNER: **T & E Oil Company**RR#, St. Address, Box # **P.O. Box 1303**

Board of Agriculture, Division of Water Resources

City, State, ZIP Code : **Hutchinson, Kansas 67504**

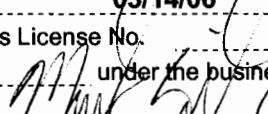
Application Number:

3	MARK WELL'S LOCATION WITH AN "X" IN SECTION BOX:	4	DEPTH OF WELL 17.0 ft.
		WELL'S STATIC WATER LEVEL 9.69 ft.	
		WELL WAS USED AS:	
		1 Domestic 5 Public Water Supply 9 Dewatering	
		2 Irrigation 6 Oil Field Water Supply 10 Monitoring Well	
		3 Feedlot 7 Lawn and Garden (domestic) 11 Injection Well	
		4 Industrial 8 Air Conditioning 12 Other	
		Was a chemical/bacteriological sample submitted to Department? Yes No X	
		If yes, mo/day/yr sample was submitted	
		Water Well Disinfected: Yes No X	

5	TYPE OF BLANK CASING USED:
1 Steel 3 RMP (SR) 5 Wrought 7 Fiberglass 9 Other (specify below)	
2 PVC 4 ABC 6 Asbestos-Cement 8 Concrete Tile	
Blank casing diameter 2.375 in. Was casing pulled? Yes X No If yes, how much? 17'	
Casing height above or below land surface Unknown in. Overdrilled well to 17'	

6	GROUT PLUG MATERIAL: 1 Neat cement 2 Cement grout 3 Bentonite 4 Other Soils/Concrete
Grout Plug Intervals From 17.0 ft. to 3.0 ft. From 3.0 ft. to 1.0 ft. From 1.0 ft. to 0.0 ft.	
What is the nearest source of possible contamination:	
1 Septic tank 6 Seepage pit 11 Fuel storage (former) 16 Other (specify below)	
2 Sewer lines 7 Pit privy 12 Fertilizer storage	
3 Watertight sewer lines 8 Sewage lagoon 13 Insecticide storage	
4 Lateral lines 9 Feedyard 14 Abandoned water well	
5 Cess Pool 10 Livestock pens 15 Oil well/ Gas well	
Direction from well? Southeast How many feet? 150	

FROM	TO	CODE	PLUGGING MATERIALS
0.0	1.0		Concrete
1.0	3.0		Soils
3.0	17.0		Bentonite chips

7	CONTRACTOR'S OR LANDOWNER'S CERTIFICATION: This water well was plugged under my jurisdiction and was completed on (mo/day/yr) 03/14/06 and this record is true to the best of my knowledge and belief. Kansas Water Well Contractor's License No. 692 This Water Well Record was completed on (mo/day/yr) 03/21/06 under the business name of Quad State Services, Inc.
	by (signature) 

INSTRUCTIONS: Please fill in blanks and circle the correct answers. Send three copies to Kansas Department of Health and Environment, Bureau of Water, 1000 S W Jackson St., Ste. 420, Topeka, Kansas 66620-0001. Telephone: 785-296-3565. Send one to Water Well Owner and retain one for your records.