

1	LOCATION OF WATER WELL:	Fraction	Section Number	Township Number	Range Number
County:	RENO	NE $\frac{1}{4}$ SW $\frac{1}{4}$ SW $\frac{1}{4}$	1	T 23 S	R 6 E/W

Distance and direction from nearest town or city street address of well if located within city?


2	WATER WELL OWNER:
---	-------------------

RR#, St. Address, Box # :  
City, State, ZIP Code :

Board of Agriculture, Division of Water Resources  
Application Number:

3 LOCATE WELL'S LOCATION WITH AN "X" IN SECTION BOX:

4 DEPTH OF COMPLETED WELL ..... 35 ..... ft. ELEVATION: .....

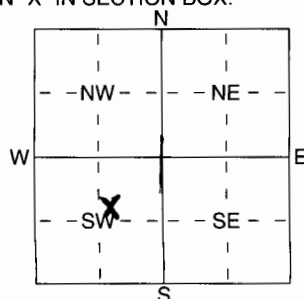

Depth(s) Groundwater Encountered 1 ..... ft. 2 ..... ft. 3 ..... ft.  
WELL'S STATIC WATER LEVEL 16 ..... ft. below land surface measured on mo/day/yr 4-28-06 .....  
Pump test data: Well water was 16.4 ..... ft. after 1 1/2 ..... hours pumping 2.5 ..... gpm  
Est. Yield ..... gpm: Well water was ..... ft. after ..... hours pumping ..... gpm  
WELL WATER TO BE USED AS:  
1 Domestic 3 Feedlot 5 Public water supply 8 Air conditioning 11 Injection well  
2 Irrigation 4 Industrial 6 Oil field water supply 9 Dewatering 12 Other (Specify below)  
7 Domestic (lawn & garden) 10 Monitoring well

Was a chemical/bacteriological sample submitted to Department? Yes ..... No ☒ ..... ; If yes, mo/day/yr sample was submitted

Water Well Disinfected? Yes ☒ No

5	TYPE OF BLANK CASING USED:
---	----------------------------

5 Wrought iron	8 Concrete tile	CASING JOINTS: Glued ..... Clamped .....
6 Asbestos-Cement	9 Other (specify below)	Welded .....
7 Fiberglass		Threaded .....

Blank casing diameter 5 in. to 23 ft. Dia      in. to      ft. Dia      in. to      ft.

Casing height above land surface ..... 12 ..... in., weight ..... 2.29 ..... lbs./ft. Wall thickness or gauge No. 160 .....

TYPE OF SCREEN OR PERFORATION MATERIAL:

IN MATERIAL:

Steel	5 Fiberglass	7 PVC	10 Asbestos-Cement
Red Steel	6 Concrete tile	8 RMP (SR)	11 Other (Specify) .....
		9 ABS	12 None used (open hole)

SCREEN OR PERFORATION OPENINGS ARE:

INGS ARE:

5 Guazed wrapped	8 Saw cut	11 None (open hole)
6 Wire wrapped	9 Drilled holes	
7 Torch cut	10 Other (specify) .....	ft.

SCREEN-PERFORATED INTERVALS: From 23 ft. to 33 ft. From \_\_\_\_\_ ft. to \_\_\_\_\_ ft.

GRAVEL PACK INTERVALS: From 16 ft. to 33 ft. From \_\_\_\_\_ ft. to \_\_\_\_\_ ft.  
From \_\_\_\_\_ ft. to \_\_\_\_\_ ft. From \_\_\_\_\_ ft. to \_\_\_\_\_ ft.

6	GROUT MATERIAL:	1 Neat cement	2 Cement grout	3 Bentonite	4 Other.....
---	-----------------	---------------	----------------	-------------	--------------

Grout Intervals: From 1 ft. to 1.6 ft., From 1.6 ft. to 2.0 ft., From 2.0 ft. to 2.4 ft.

What is the nearest source of possible contamination:

contamination:		10 Livestock pens	14 Abandoned water well
ral lines	7 Pit privy	11 Fuel storage	15 Oil well/Gas well
s pool	8 Sewage lagoon	12 Fertilizer storage	16 Other (specify below)
page pit	9 Feedyard	13 Insecticide storage	.....

Direction from well?

How many feet? 50

[illegible]

7 CONTRACTOR'S OR LANDOWNER'S CERTIFICATION: This water well was (1) constructed, (2) reconstructed, or (3) plugged under my jurisdiction and was completed on (mo/day/year) 4-28-06 and this record is true to the best of my knowledge and belief. Kansas Water Well Contractor's Licence No. 750 This Water Well Record was completed on (mo/day/yr) 4-28-06 under the business name of 1-21-5223 Water Systems by (signature) E. L. [illegible]