

1 LOCATION OF WATER WELL: County: <b>Reno</b>	Fraction NW ¼ SW ¼ SE ¼	Section Number <b>25</b>	Township Number T <b>23</b> S	Range Number R <b>6</b> <b>EW</b>
--------------------------------------------------	----------------------------	-----------------------------	----------------------------------	--------------------------------------

Distance and direction from nearest town or city street address of well if located within city?

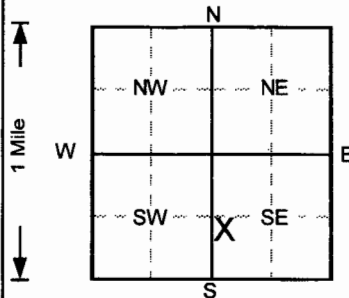
**1/4 mi. N of W end of Wilbeck Dr., So. Hutchinson**2 WATER WELL OWNER: **Kansas Dept. of Health & Environment**RR#, St. Address, Box # : **1000 SW Jackson, Suite 410**

Board of Agriculture, Division of Water Resources

City, State, ZIP Code : **Topeka, Kansas 66612-1367**

Application Number:

## 3 LOCATE WELL'S LOCATION WITH AN "X" IN SECTION BOX:

4 DEPTH OF COMPLETED WELL **15.8** ft. ELEVATION:

Depth(s) Groundwater Encountered 1. .... ft. 2. .... ft. 3. .... ft.

WELL'S STATIC WATER LEVEL ..... ft. below land surface measured on mo/day/yr

Pump test data: Well water was **NA** ft. after ..... hours pumping ..... gpmEst. Yield **NA** gpm: Well water was ..... ft. after ..... hours pumping ..... gpmBore Hole Diameter **8** in. to **16** ft. and ..... in. to ..... ft.

WELL WATER TO BE USED AS: 5 Public water supply 8 Air conditioning 11 Injection well

1 Domestic 3 Feedlot 6 Oil field water supply 9 Dewatering 12 Other (Specify below)

2 Irrigation 4 Industrial 7 Lawn and garden only **10** Monitoring wellWas a chemical/bacteriological sample submitted to Department? Yes.....No ☒; If yes, mo/day/yr sample was submittedWater Well Disinfected? Yes No ☒

## 5 TYPE OF BLANK CASING USED:

1 Steel 3 RMP (SR) 5 Wrought iron 8 Concrete tile CASING JOINTS: Glued ..... Clamped .....

**2** PVC 4 ABS 6 Asbestos-Cement 9 Other (specify below) Welded .....

Blank casing diameter ..... in. to ..... ft. Dia ..... in. to ..... ft. Dia ..... in. to ..... ft.

Casing height above land surface **30** in., weight ..... lbs./ft. Wall thickness or gauge No. **Sch. 40**

## TYPE OF SCREEN OR PERFORATION MATERIAL

1 Steel 3 Stainless steel 5 Fiberglass **7** PVC 10 Asbestos-cement

2 Brass 4 Galvanized steel 6 Concrete tile 9 ABS 11 Other (specify) .....

12 None used (open hole)

## SCREEN OR PERFORATION OPENINGS ARE:

1 Continuous slot **3** Mill slot 5 Gauzed wrapped 8 Saw cut 11 None (open hole)

2 Louvered shutter 4 Key punched 6 Wire wrapped 9 Drilled holes

7 Torch cut 10 Other (specify) .....

SCREEN-PERFORATED INTERVALS: From **9.8** ft. to **15.8** ft. From ..... ft. to ..... ft.

From ..... ft. to ..... ft. From ..... ft. to ..... ft.

GRAVEL PACK INTERVALS: From **8** ft. to **16** ft. From ..... ft. to ..... ft.

From ..... ft. to ..... ft. From ..... ft. to ..... ft.

6 GROUT MATERIAL: 1 Neat cement 2 Cement grout **3** Bentonite 4 OtherGrout Intervals: From **2** ft. to **8** ft. From ..... ft. to ..... ft. From ..... ft. to ..... ft.

What is the nearest source of possible contamination:

1 Septic tank 4 Lateral lines 7 Pit privy 10 Livestock pens 14 Abandoned water well

2 Sewer lines 5 Cess pool 8 Sewage lagoon 11 Fuel storage 15 Oil well/Gas well

3 Watertight sewer lines 6 Seepage pit 9 Feedyard 12 Fertilizer storage 16 Other (specify below)

13 Insecticide storage

Direction from well? How many feet?

FROM TO LITHOLOGIC LOG FROM TO PLUGGING INTERVALS

0 2 Clay, silty, moist, no odor, Brown

2 9 Silt, moist, sl. odor, Brown to Gray-Brown

9 12 Sand (vf-m), v. sl. odor, Brown

12 16 Sand (vf-m), saturated, Brown to Gray-Brown