

1) LOCATION OF WATER WELL:										Fraction		Section Number		Township Number		Range Number	
County: Reno										NW ¼ SW ¼ SE ¼		25		T 23 S		R 6 E W	

1) LOCATION OF WATER WELL:										Fraction		Section Number			Township Number			Range Number			
County: Reno										NW ¼	SW ¼	SE ¼	25		T	23		S	R	6	E W

Distance and direction from nearest town or city street address of well if located within city?

1/4 mi. N of W end of Wilbeck Dr., So. Hutchinson

2] WATER WELL OWNER: Kansas Dept. of Health & Environment		
RR#, St. Address, Box #	: 1000 SW Jackson, Suite 410	Board of Agriculture, Division of Water Resources
City, State, ZIP Code	: Topeka, Kansas 66612-1367	Application Number:

3 LOCATE WELL'S LOCATION WITH AN "X" IN SECTION BOX:

1 Mile

W E

N S

NW NE SW SE

X

4 DEPTH OF COMPLETED WELL 16.5 ft. ELEVATION:

Depth(s) Groundwater Encountered 1. ft. 2. ft. 3. ft.

WELL'S STATIC WATER LEVEL ft. below land surface measured on mo/day/yr

Pump test data: Well water was NA ft. after hours pumping gpm

Est. Yield NA gpm: Well water was ft. after hours pumping gpm


Bore Hole Diameter 8 in. to 16.5 ft. and in. to ft.

WELL WATER TO BE USED AS:

5 Public water supply	8 Air conditioning	11 Injection well
1 Domestic	3 Feedlot	6 Oil field water supply
2 Irrigation	4 Industrial	7 Lawn and garden only
		10 Monitoring 10 المراقبة
		12 Other (Specify below)

Was a chemical/bacteriological sample submitted to Department? Yes.....No ☒

Water Well Disinfected? Yes No ☒

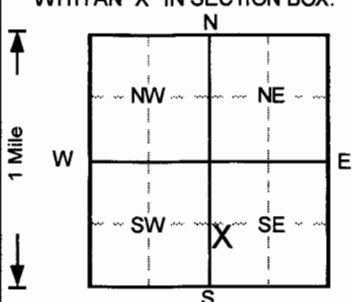

5 TYPE OF BLANK CASING USED:

1 Steel	3 RMP (SR)	5 Wrought iron	8 Concrete tile	CASING JOINTS: Glued Clamped
2 PVC	4 ABS	6 Asbestos-Cement	9 Other (specify below)	Welded
		7 Fiberglass		Threaded. ☒

Blank casing diameter 2 in. to 10.5 ft., Dia in. to ft., Dia in. to ft.

Casing height above land surface 30 in., weight lbs./ft. Wall thickness or gauge No. Sch. 40

TYPE OF SCREEN OR PERFORATION MATERIAL

1 Steel	3 Stainless steel	5 Fiberglass	7 PVC	10 Asbestos-cement
2 Brass	4 Galvanized steel	6 Concrete tile	8 RMP (SR)	11 Other (specify)
			9 ABS	12 None used (open hole)

SCREEN OR PERFORATION OPENINGS ARE:

1 Continuous slot	3 Mill slot	5 Gauzed wrapped	8 Saw cut	11 None (open hole)
2 Louvered shutter	4 Key punched	6 Wire wrapped	9 Drilled holes	
		7 Torch cut	10 Other (specify)	

SCREEN-PERFORATED INTERVALS: From 10.5 ft. to 16.5 ft., From ft. to ft.

From ft. to ft., From ft. to ft.

GRAVEL PACK INTERVALS: From 8.5 ft. to 16.5 ft., From ft. to ft.

From ft. to ft., From ft. to ft.

6] GROUT MATERIAL: 1 Neat cement 2 Cement grout 3 Bentonite 4 Other

Grout intervals: From 2 ft. to 8.5 ft. From ft. to ft. From ft. to ft.

What is the nearest source of possible contamination:

1 Septic tank	4 Lateral lines	7 Pit privy	10 Livestock pens	14 Abandoned water well
2 Sewer lines	5 Cess pool	8 Sewage lagoon	11 Fuel storage	15 Oil well/Gas well
3 Watertight sewer lines	6 Seepage pit	9 Feedyard	12 Fertilizer storage	16 Other (specify below)
			13 Insecticide storage	

Direction from well? How many feet?

[illegible]

7. CONTRACTOR'S OR LANDOWNER'S CERTIFICATION: This water well was (1) constructed, (2) reconstructed, or (3) plugged under my jurisdiction and was completed on (mo/day/year) 9/28/2007 and this record is true to the best of my knowledge and belief.
Kansas Water Well Contractor's License No. 527 This Water Well Record was completed on (mo/day/yr) 10/22/07 under the business name of GeoCore, Inc. by (signature) [Signature]