

LOCATION OF WATER WELL:	Fraction	Section Number	Township Number	Range Number
RENO	SW ¼ SE ¼ NW ¼	13	23 SOUTH	06 WEST


Distance and direction from nearest town or city street address of well if located within city?

APPROXIMATELY 218 FT. NORTH AND 112 FT. EAST OF THE INTERSECTION OF S. ADAMS AVE. &amp; W. AVENUE B, HUTCHINSON, KS

well no. 2

RR#, St. Address, Box #:  
City, State, ZIP Code:RENO COUNTY, KANSAS  
206 W 1<sup>ST</sup> AVE.  
HUTCHINSON, KS 67501Board of Agriculture, Division of Water Resources  
Application Number:MARK WELL'S LOCATION WITH  
AN "X" IN SECTION BOX

N

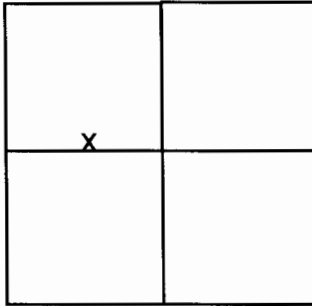

S

DEPTH OF WELL 40 ft.

WELL'S STATIC WATER LEVEL 13.5 ft.

WELL WAS USED AS:

- |              |                          |                           |
|--------------|--------------------------|---------------------------|
| 1 Domestic   | 5 Public Water Supply    | 9 Dewatering              |
| 2 Irrigation | 6 Oil Field Water Supply | 10 Monitoring Well        |
| 3 Feedlot    | 7 Lawn and Garden Only   | 11 Injection Well         |
| 4 Industrial | 8 Air Conditioning       | <b>12 Other - Unknown</b> |

Was a chemical/bacteriological sample submitted to Department? Yes ☐ No ☒

If yes, mo/day/yr sample was submitted: / /

WaterWell Disinfected: Yes ☒ No ☐

TYPE OF BLANK CASING USED:

- |              |            |                   |                 |         |
|--------------|------------|-------------------|-----------------|---------|
| 1 Steel      | 3 RMP (SR) | 5 Wrought         | 7 Fiberglass    | 9 Other |
| <b>2 PVC</b> | 4 ABS      | 6 Asbestos-Cement | 8 Concrete Tile |         |

Blank casing diameter 6.0 in. Was casing pulled? Yes ☐ No ☒ if yes, how much 0.0 ft bls

Casing height above or below land surface 5 feet.

GROUT PLUG MATERIAL: 1 Neat cement 2 Cement grout **3 Bentonite** 4 Other

Grout Plug Intervals: From 40 ft. to 5 ft.

What is the nearest source of possible contamination:

- |                                 |                   |                         |          |
|---------------------------------|-------------------|-------------------------|----------|
| 1 Septic tank                   | 6 Seepage pit     | 11 Fuel Storage         | 16 Other |
| 2 Sewer lines                   | 7 Pit privy       | 12 Fertilizer storage   |          |
| <b>3 Watertight sewer lines</b> | 8 Sewage lagoon   | 13 Insecticide storage  |          |
| 4 Lateral lines                 | 9 Feedyard        | 14 Abandoned water well |          |
| 5 Cess Pool                     | 10 Livestock pens | 15 Oil well / Gas well  |          |

Direction from well? North

How many feet? approximately 61 ft.

FROM	TO	PLUGGING MATERIALS
40	5	Bentonite, HolePlug
5	0	Topsoil

David Randolph, GMD2 staff  
witnessed the plugging of the  
abandoned well on 9/13/07

CONTRACTOR'S OR LANDOWNER'S CERTIFICATION: This water well was plugged under my jurisdiction and was completed on (mo/day/year) 09 / 13 / 2007 and this record is true to the best of my knowledge and belief.

Kansas Water Well Contractor's License No. NA under the business name of

by (signature) *Frances J. Garcia* Frances J. Garcia, Commission Chair

INSTRUCTIONS: Use typewriter or ball point pen. Please press firmly and print clearly. Please fill in blanks, and underline or circle the correct answers. Send top three copies to Kansas Department of Health and Environment, Bureau of Water, Topeka, Kansas 66620-0001. Telephone: 913/296-3565. Send one to Water Well Owner and retain one for your records.