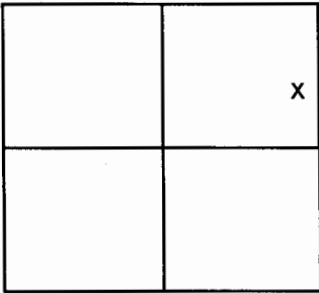


LOCATION OF WATER WELL: <b>RENO</b>	Fraction <b>NE ¼ SE ¼ NE ¼</b>	Section Number <b>36</b>	Township Number <b>23 SOUTH</b>	Range Number <b>06 WEST</b>																								
Distance and direction from nearest town or city street address of well if located within city? <b>APPROXIMATELY 414 FT. WEST AND 1110 FT. SOUTH OF THE INTERSECTION OF ILLINOIS AVE. &amp; MCNEW RD., HUTCHINSON, KS</b>																												
WATER WELL OWNER: <div style="display: flex; justify-content: space-between;"><div>RR#, St. Address, Box #: City, State, ZIP Code:</div><div><b>CARGILL SALT CO., INC.</b> <b>609 E. AVE. G</b> <b>HUTCHINSON, KS 67501</b></div><div>Board of Agriculture, Division of Water Resources Application Number: 41665-B</div></div>																												
MARK WELL'S LOCATION WITH AN "X" IN SECTION BOX <div style="text-align: center;"> S</div>		DEPTH OF WELL <b>50 ft.</b>  WELL'S STATIC WATER LEVEL <b>10 ft.</b>  WELL WAS USED AS: <table style="width:100%;"><tr><td>1 Domestic</td><td>5 Public Water Supply</td><td>9 Dewatering</td></tr><tr><td>2 Irrigation</td><td>6 Oil Field Water Supply</td><td>10 Monitoring Well</td></tr><tr><td>3 Feedlot</td><td>7 Lawn and Garden Only</td><td>11 Injection Well</td></tr><tr><td>4 Industrial</td><td>8 Air Conditioning</td><td><u>12 Other - Recreation</u></td></tr></table> Was a chemical/bacteriological sample submitted to Department? Yes <input type="checkbox"/> No <input checked="" type="checkbox"/> If yes, mo/day/yr sample was submitted :     /     /  WaterWell Disinfected: Yes <input checked="" type="checkbox"/> No <input type="checkbox"/>			1 Domestic	5 Public Water Supply	9 Dewatering	2 Irrigation	6 Oil Field Water Supply	10 Monitoring Well	3 Feedlot	7 Lawn and Garden Only	11 Injection Well	4 Industrial	8 Air Conditioning	<u>12 Other - Recreation</u>												
1 Domestic	5 Public Water Supply	9 Dewatering																										
2 Irrigation	6 Oil Field Water Supply	10 Monitoring Well																										
3 Feedlot	7 Lawn and Garden Only	11 Injection Well																										
4 Industrial	8 Air Conditioning	<u>12 Other - Recreation</u>																										
TYPE OF BLANK CASING USED: <table style="width:100%;"><tr><td>1 Steel</td><td>3 RMP (SR)</td><td>5 Wrought</td><td>7 Fiberglass</td><td>9 Other _____</td></tr><tr><td><u>2 PVC</u></td><td>4 ABS</td><td>6 Asbestos-Cement</td><td>8 Concrete Tile</td><td></td></tr></table> Blank casing diameter <b>8.0 in.</b> Was casing pulled? Yes <input type="checkbox"/> No <input checked="" type="checkbox"/> if yes, how much <b>0.0 ft</b> bls Casing height above or below land surface <b>3 feet.</b>					1 Steel	3 RMP (SR)	5 Wrought	7 Fiberglass	9 Other _____	<u>2 PVC</u>	4 ABS	6 Asbestos-Cement	8 Concrete Tile															
1 Steel	3 RMP (SR)	5 Wrought	7 Fiberglass	9 Other _____																								
<u>2 PVC</u>	4 ABS	6 Asbestos-Cement	8 Concrete Tile																									
GROUT PLUG MATERIAL: 1 Neat cement 2 Cement grout <u>3 Bentonite</u> 4 Other Grout Plug Intervals: From <b>10 ft.</b> to <b>3 ft.</b> What is the nearest source of possible contamination: <table style="width:100%;"><tr><td>1 Septic tank</td><td>6 Seepage pit</td><td>11 Fuel Storage</td><td><u>16 Other – Groundwater Pit</u></td></tr><tr><td>2 Sewer lines</td><td>7 Pit privy</td><td>12 Fertilizer storage</td><td></td></tr><tr><td>3 Watertight sewer lines</td><td>8 Sewage lagoon</td><td>13 Insecticide storage</td><td></td></tr><tr><td>4 Lateral lines</td><td>9 Feedyard</td><td>14 Abandoned water well</td><td></td></tr><tr><td>5 Cess Pool</td><td>10 Livestock pens</td><td>15 Oil well / Gas well</td><td></td></tr></table> Direction from well? <b>North Northwest</b> How many feet? approximately <b>150 ft.</b>					1 Septic tank	6 Seepage pit	11 Fuel Storage	<u>16 Other – Groundwater Pit</u>	2 Sewer lines	7 Pit privy	12 Fertilizer storage		3 Watertight sewer lines	8 Sewage lagoon	13 Insecticide storage		4 Lateral lines	9 Feedyard	14 Abandoned water well		5 Cess Pool	10 Livestock pens	15 Oil well / Gas well					
1 Septic tank	6 Seepage pit	11 Fuel Storage	<u>16 Other – Groundwater Pit</u>																									
2 Sewer lines	7 Pit privy	12 Fertilizer storage																										
3 Watertight sewer lines	8 Sewage lagoon	13 Insecticide storage																										
4 Lateral lines	9 Feedyard	14 Abandoned water well																										
5 Cess Pool	10 Livestock pens	15 Oil well / Gas well																										
<table border="1" style="width:100%; border-collapse: collapse;"><thead><tr><th style="width:15%;">FROM</th><th style="width:15%;">TO</th><th style="width:70%;">PLUGGING MATERIALS</th></tr></thead><tbody><tr><td>50</td><td>10</td><td>Coarse Sand</td></tr><tr><td>10</td><td>3</td><td>Bentonite HolePlug</td></tr><tr><td>3</td><td>0</td><td>Topsoil</td></tr><tr><td> </td><td> </td><td> </td></tr><tr><td> </td><td> </td><td> </td></tr><tr><td> </td><td> </td><td> </td></tr><tr><td> </td><td> </td><td> </td></tr></tbody></table>			FROM	TO	PLUGGING MATERIALS	50	10	Coarse Sand	10	3	Bentonite HolePlug	3	0	Topsoil													David Randolph, GMD2 staff witnessed the plugging of the abandoned well on 11/30/07	
FROM	TO	PLUGGING MATERIALS																										
50	10	Coarse Sand																										
10	3	Bentonite HolePlug																										
3	0	Topsoil																										
CONTRACTOR'S OR LANDOWNER'S CERTIFICATION: This water well was plugged under my jurisdiction and was completed on (mo/day/year) <b>11 / 30 / 2007</b> and this record is true to the best of my knowledge and belief. Kansas Water Well Contractor's License No. <b>NA</b> under the business name of by (signature) <i>Mark Whitson</i> Mark Whitson, Assistant Plant Manager																												
INSTRUCTIONS: Use typewriter or ball point pen. Please press firmly and print clearly. Please fill in blanks, and underline or circle the correct answers. Send top three copies to Kansas Department of Health and Environment, Bureau of Water, Topeka, Kansas 66620-0001. Telephone: 913/296-3565. Send one to Water Well Owner and retain one for your records.																												