

Corrected

WATER WELL PLUGGING RECORD

Form WWC-5P

KSA 82a-1212

ID No.

MW-3

1 LOCATION OF WATER WELL: County: Reno	Fraction SE 1/4 SE 1/4 SE 1/4	Section Number 1	Township Number 23S	Range Number 6W
---	----------------------------------	---------------------	------------------------	--------------------


Distance and direction from nearest town or city street address of well if located within city?

434 East 17th Street, Hutchinson, KS

2 WATER WELL OWNER: Owen's Oil  
RR#, St. Address, Box # 434 East 17th Street  
City, State, ZIP Code Hutchinson, KS 67501

Board of Agriculture, Division of Water Resources  
Application Number:

3 MARK WELL'S LOCATION WITH AN "X" IN SECTION BOX:

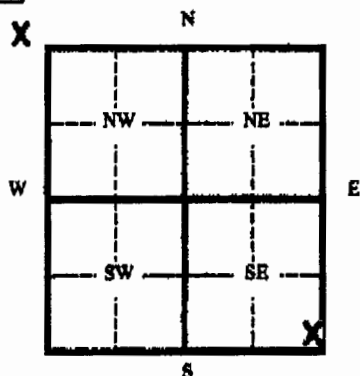

4 DEPTH OF WELL 24.5 ft.

WELL'S STATIC WATER LEVEL 12.03 ft.

WELL WAS USED AS:

- |              |                              |                    |
|--------------|------------------------------|--------------------|
| 1 Domestic   | 5 Public Water Supply        | 9 Dewatering       |
| 2 Irrigation | 6 Oil Field Water Supply     | 10 Monitoring Well |
| 3 Feedlot    | 7 Lawn and Garden (domestic) | 11 Injection Well  |
| 4 Industrial | 8 Air Conditioning           | 12 Other           |

Was a chemical/bacteriological sample submitted to Department? Yes No

If yes, mo/day/yr sample was submitted

Water Well Disinfected: Yes No

5 TYPE OF BLANK CASING USED:

- 1 Steel 3 RMP (SR) 5 Wrought 7 Fiberglass 9 Other (specify below)

- 2 PVC 4 ABC 6 Asbestos-Cement 8 Concrete Tile

Blank casing diameter 2 in. Was casing pulled? Yes X No If yes, how much 3 ft.

Casing height above or below land surface -36 in.

6 GROUT PLUG MATERIAL: 1 Neat cement 2 Cement grout 3 Bentonite 4 Other

Grout Plug Intervals From 0.5 ft. to 24.5 ft. From ft. to ft. From ft. to ft.

What is the nearest source of possible contamination:

- |                          |                   |                         |                          |
|--------------------------|-------------------|-------------------------|--------------------------|
| 1 Septic tank            | 6 Seepage pit     | 11 Fuel storage         | 16 Other (specify below) |
| 2 Sewer lines            | 7 Pit privy       | 12 Fertilizer storage   |                          |
| 3 Watertight sewer lines | 8 Sewage lagoon   | 13 Insecticide storage  |                          |
| 4 Lateral lines          | 9 Feedyard        | 14 Abandoned water well |                          |
| 5 Cess Pool              | 10 Livestock pens | 15 Oil well/ Gas well   |                          |

Direction from well?

How many feet?

FROM	TO	CODE	PLUGGING MATERIALS
0	0.5		Concrete
0.5	24.5		Hydrated bentonite chips

RECEIVED

JAN 08 2009

BUREAU OF WATER

7 CONTRACTOR'S OR LANDOWNER'S CERTIFICATION: This water well was plugged under my jurisdiction and was completed on (mo/day/yr) 12/1/08 and this record is true to the best of my knowledge and belief. Kansas Water Well Contractor's License No. 554 This Water Well Record was completed on (mo/day/yr) 12/11/08 under the business name of Bluestem Environmental Engineering, Inc. by (signature) [Signature]

INSTRUCTIONS: Please fill in blanks and circle the correct answers. Send three copies to Kansas Department of Health and Environment, Bureau of Water, 1000 S W Jackson St., Ste. 420, Topeka, Kansas 66620-0001. Telephone: 785-298-3585. Send one to Water Well Owner and retain one for your records.