

Corrected

WATER WELL PLUGGING RECORD

Form WWC-5P

KSA 82a-1212


ID No.

MW-4

1 LOCATION OF WATER WELL: County: Reno	Fraction SE 1/4 SE 1/4 SE 1/4	Section Number 1	Township Number 23S	Range Number 6W
---	----------------------------------	---------------------	------------------------	--------------------

Distance and direction from nearest town or city street address of well if located within city?
434 East 17th Street, Hutchinson, KS

2 WATER WELL OWNER: Owen's Oil
 RR#, St. Address, Box # 434 East 17th Street
 City, State, ZIP Code Hutchinson, KS 67501
 Board of Agriculture, Division of Water Resources
 Application Number:

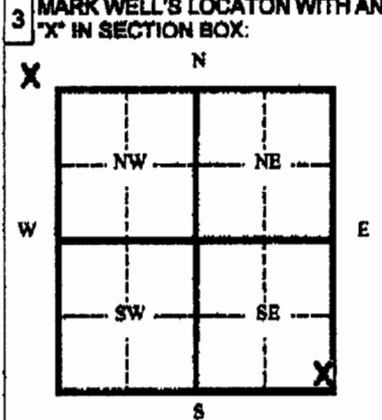

4 DEPTH OF WELL 23.4 ft.
 WELL'S STATIC WATER LEVEL 13.18 ft.
 WELL WAS USED AS:
 1 Domestic 5 Public Water Supply 9 Dewatering
 2 Irrigation 6 Oil Field Water Supply 10 Monitoring Well
 3 Feedlot 7 Lawn and Garden (domestic) 11 Injection Well
 4 Industrial 8 Air Conditioning 12 Other
 Was a chemical/bacteriological sample submitted to Department? Yes No
 If yes, mo/day/yr sample was submitted
 Water Well Disinfected: Yes No

5 TYPE OF BLANK CASING USED:
 1 Steel 3 RMP (SR) 5 Wrought 7 Fiberglass 9 Other (specify below)
 2 PVC 4 ABC 6 Asbestos-Cement 8 Concrete Tile
 Blank casing diameter 2 in. Was casing pulled? Yes No if yes, how much 3 ft.
 Casing height above or below land surface -36 in.

6 GROUT PLUG MATERIAL: 1 Neat cement 2 Cement grout 3 Bentonite 4 Other
 Grout Plug Intervals From 0.5 ft. to 23.4 ft. From ft. to ft. From ft. to ft.
 What is the nearest source of possible contamination:
 1 Septic tank 6 Seepage pit 11 Fuel storage 16 Other (specify below)
 2 Sewer lines 7 Pit privy 12 Fertilizer storage
 3 Watertight sewer lines 8 Sewage lagoon 13 Insecticide storage
 4 Lateral lines 9 Feedyard 14 Abandoned water well
 5 Cess Pool 10 Livestock pens 15 Oil well/ Gas well
 Direction from well? How many feet?

FROM	TO	CODE	PLUGGING MATERIALS
0	0.5		Concrete
0.5	23.4		Hydrated bentonite chips

RECEIVED
 JAN 08 2009
BUREAU OF WATER

7 CONTRACTOR'S OR LANDOWNER'S CERTIFICATION: This water well was plugged under my jurisdiction and was completed on (mo/day/yr) 12/11/08 and this record is true to the best of my knowledge and belief. Kansas Water Well Contractor's License No. 554 This Water Well Record was completed on (mo/day/yr) 12/11/08 under the business name of Bluestem Environmental Engineering, Inc. by (signature) *Nick Holt*

INSTRUCTIONS: Please fill in blanks and circle the correct answers. Send three copies to Kansas Department of Health and Environment, Bureau of Water, 1000 S W Jackson St., Ste. 420, Topeka, Kansas 66620-0001. Telephone: 785-298-3565. Send one to Water Well Owner and retain one for your records.