

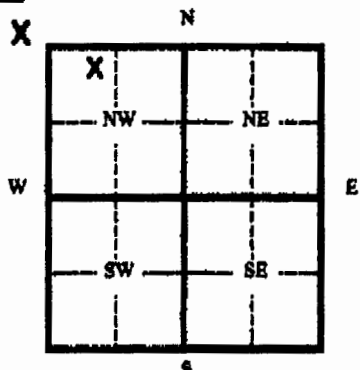
WATER WELL PLUGGING RECORD

Form WWC-5P

KSA 82a-1212

ID No.

MW-10

1 LOCATION OF WATER WELL:		Fraction	Section Number	Township Number	Range Number
County: Reno		NE $\frac{1}{4}$ NW $\frac{1}{4}$ NW $\frac{1}{4}$	2	23S	6W
Distance and direction from nearest town or city street address of well if located within city? 1301 West 30th Avenue, Hutchinson, KS					
2 WATER WELL OWNER: Jack Glaves RR#, St. Address, Box # 120 S. Market, Suite 600 City, State, ZIP Code: Wichita, KS 67202 Board of Agriculture, Division of Water Resources Application Number:					
3 MARK WELL'S LOCATION WITH AN "X" IN SECTION BOX:		4 DEPTH OF WELL 20.3 ft. WELL'S STATIC WATER LEVEL 15 ft. WELL WAS USED AS: 1 Domestic 5 Public Water Supply 9 Dewatering 2 Irrigation 6 Oil Field Water Supply 10 Monitoring Well 3 Feedlot 7 Lawn and Garden (domestic) 11 Injection Well 4 Industrial 8 Air Conditioning 12 Other Was a chemical/bacteriological sample submitted to Department? Yes No If yes, mo/day/yr sample was submitted Water Well Disinfected: Yes No			
					
5 TYPE OF BLANK CASING USED: 1 Steel 3 RMP (SR) 5 Wrought 7 Fiberglass 9 Other (specify below) 2 PVC 4 ABC 6 Asbestos-Cement 8 Concrete Tile Blank casing diameter 2 in. Was casing pulled? Yes X No If yes, how much 3 ft. Casing height above or below land surface 36 in.					
6 GROUT PLUG MATERIAL: 1 Neat cement 2 Cement grout 3 Bentonite 4 Other Grout Plug Intervals From 0 ft. to 20.3 ft. From ft. to ft. From ft. to ft. What is the nearest source of possible contamination: 1 Septic tank 6 Seepage pit 11 Fuel storage 16 Other (specify below) 2 Sewer lines 7 Pit privy 12 Fertilizer storage 3 Watertight sewer lines 8 Sewage lagoon 13 Insecticide storage 4 Lateral lines 9 Feedyard 14 Abandoned water well 5 Cess Pool 10 Livestock pens 15 Oil well/ Gas well Direction from well? How many feet?					
FROM	TO	CODE	PLUGGING MATERIALS		
0	20.3		Bentonite		
7 CONTRACTOR'S OR LANDOWNER'S CERTIFICATION: This water well was plugged under my jurisdiction and was completed on (mo/day/yr) 4/18/07 and this record is true to the best of my knowledge and belief. Kansas Water Well Contractor's License No. 554 This Water Well Record was completed on (mo/day/yr) 5/3/07 under the business name of Woofer Pump and Well by (signature) Joy Wofer byt					
INSTRUCTIONS: Please fill in blanks and circle the correct answers. Send three copies to Kansas Department of Health and Environment, Bureau of Water, 1000 S W Jackson St., Ste. 420, Topeka, Kansas 66620-0001. Telephone: 785-298-3585. Send one to Water Well Owner and retain one for your records.					

RECEIVED
JAN 08 2009
BUREAU OF WATER