


1 LOCATION OF WATER WELL:	Fraction	Section Number	Township Number	Range Number
County: <u>Reno</u>	<u>NW 1/4 NW 1/4 NE 1/4</u>	<u>1</u>	<u>23</u>	<u>6</u> <span style="float: right;">EW</span>

Distance and direction from nearest town or city street address of well if located within city?  
25 E. 30th St. Hutchinson KS 67501

2	WATER WELL OWNER: <u>Danny's OK Service</u> <u>25 E. 30th St.</u> RR #, St. Address, Box #: City, State, ZIP Code: <u>Hutchinson KS 67501</u>	Board of Agriculture, Division of Water Resources Application Number:
---	--	--

3 MARK WELL'S LOCATION WITH AN "X" IN SECTION BOX:	4 DEPTH OF WELL <u>20</u> ft. WELL'S STATIC WATER LEVEL <u>14.5</u> ft. WELL WAS USED AS: <div style="display: flex; justify-content: space-between;"> <div> 1 Domestic  2 Irrigation  3 Feedlot  4 Industrial </div> <div> 5 Public Water Supply  6 Oil Field Water Supply  7 Domestic (Lawn &amp; Garden)  8 Air Conditioning </div> <div> 9 Dewatering  <u>10</u> Monitoring Well  11 Injection Well  12 Other </div> </div> <p>Was a chemical / bacteriological sample submitted to Department? Yes ..... No <u>X</u>.....  If yes, mo/day/yr sample was submitted .....</p> <p>Water Well Disinfected: Yes ..... No <u>X</u>.....</p>
--	---

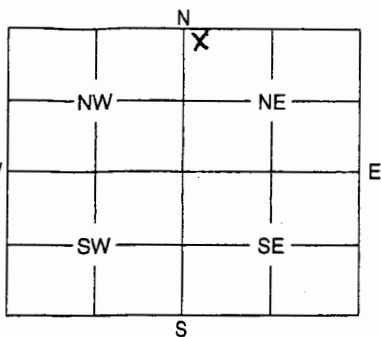

5	TYPE OF BLANK CASING USED: <div style="display: flex; justify-content: space-between;"> <div> 1 Steel  <u>2</u> PVC </div> <div> 3 RMP (SR)  4 ABS </div> <div> 5 Wrought  6 Asbestos-Cement </div> <div> 7 Fiberglass  8 Concrete Tile </div> <div> 9 Other (Specify below) </div> </div> <p>Blank casing diameter <u>2</u> in.      Was casing pulled? Yes <u>X</u> No .....      If yes, how much <u>3'</u>  Casing height above or below land surface <u>36</u> in.</p>
---	--

6	GROUT PLUG MATERIAL:      1 Neat cement      2 Cement grout <u>3</u> Bentonite      4 Other ..... Grout Plug Intervals:      From <u>3</u> ft. to <u>20</u> ft.,      From ..... ft. to ..... ft.,      From ..... ft. to ..... ft. What is the nearest source of possible contamination: <div style="display: flex; justify-content: space-between;"> <div> 1 Septic tank  2 Sewer lines  <u>3</u> Watertight sewer lines  4 Lateral lines  5 Cess pool </div> <div> 6 Seepage pit  7 Pit privy  8 Sewage lagoon  9 Feedyard  10 Livestock pens </div> <div> 11 Fuel storage  12 Fertilizer storage  13 Insecticide storage  14 Abandoned water well  15 Oil well/Gas well </div> <div> 16 Other (specify below) </div> </div> <p>Direction from well? .....      How many feet? .....</p>
---	--

FROM	TO	PLUGGING MATERIALS
20'	3'	Bentonite chips
3'	0'	Native material

7	CONTRACTOR'S OF LANDOWNER'S CERTIFICATION: This water well was plugged under my jurisdiction and was completed on (mo/day/year) <u>7-21-09</u> and this record is true to the best of my knowledge and belief. Kansas Water Well Contractor's License No. .... This Water Well Record was completed on (mo/day/year) <u>8-12-09</u> under the business name of <u>GreenField Contractors</u> by (signature) <u>John P. ...</u>
---	---