

1 LOCATION OF WATER WELL: County: Reno	Fraction NW ¼ SW ¼ NE ¼	Section Number 26	Township Number T 23 S	Range Number R 6 E/W
--	-----------------------------------	-----------------------------	----------------------------------	--------------------------------

Distance and direction from nearest town or city street address of well if located within city?

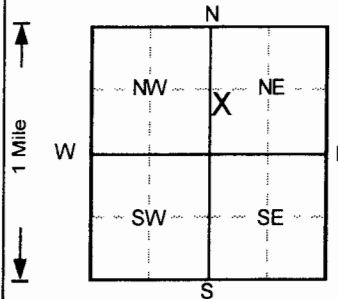
420 W. Avenue D, South Hutchinson2 WATER WELL OWNER: **SELS Administrative Services, LLC**RR#, St. Address, Box # : **11206 Thompson Ave.**

Board of Agriculture, Division of Water Resources

City, State, ZIP Code : **Lenexa, Kansas 66219**

Application Number:

3 LOCATE WELL'S LOCATION WITH AN "X" IN SECTION BOX:

4 DEPTH OF COMPLETED WELL **35** ft. ELEVATION: **1536.4**

Depth(s) Groundwater Encountered 1. ft. 2. ft. 3. ft.

WELL'S STATIC WATER LEVEL ft. below land surface measured on mo/day/yr

Pump test data: Well water was **NA** ft. after hours pumping gpmEst. Yield **NA** gpm: Well water was ft. after hours pumping gpmBore Hole Diameter **8** in. to **36** ft. and in. to ft.

WELL WATER TO BE USED AS: 5 Public water supply 8 Air conditioning 11 Injection well

1 Domestic 3 Feedlot 6 Oil field water supply 9 Dewatering **12 Other (Specify below)**2 Irrigation 4 Industrial 7 Lawn and garden only 10 Monitoring **Air sparge**Was a chemical/bacteriological sample submitted to Department? Yes.....No ☒; If yes, mo/day/yr sample was submittedWater Well Disinfected? Yes No ☒

5 TYPE OF BLANK CASING USED:

1 Steel 3 RMP (SR)

5 Wrought iron

8 Concrete tile

CASING JOINTS: Glued Clamped

2 PVC 4 ABS

6 Asbestos-Cement

9 Other (specify below)

Welded

7 Fiberglass

Threaded. ☒

Blank casing diameter 2 in. to 32.5 ft. Dia in. to ft. Dia in. to ft.

Casing height above land surface -5.64 in., weight lbs./ft. Wall thickness or gauge No. **Sch. 40**

TYPE OF SCREEN OR PERFORATION MATERIAL

1 Steel 3 Stainless steel

5 Fiberglass

7 PVC

10 Asbestos-cement

2 Brass 4 Galvanized steel

6 Concrete tile

8 RMP (SR)

11 Other (specify)

9 ABS

12 None used (open hole)

SCREEN OR PERFORATION OPENINGS ARE:

1 Continuous slot **3** Mill slot

5 Gauzed wrapped

8 Saw cut

11 None (open hole)

2 Louvered shutter 4 Key punched

6 Wire wrapped

9 Drilled holes

7 Torch cut

10 Other (specify)

SCREEN-PERFORATED INTERVALS: From 32.5 ft. to 35 ft. From ft. to ft. From ft. to ft.

GRAVEL PACK INTERVALS: From 20 ft. to 36 ft. From ft. to ft. From ft. to ft.

From ft. to ft. From ft. to ft. From ft. to ft.

6 GROUT MATERIAL:

1 Neat cement

2 Cement grout

3 Bentonite

4 Other

Grout Intervals: From 3 ft. to 20 ft. From ft. to ft. From ft. to ft.

What is the nearest source of possible contamination:

1 Septic tank

4 Lateral lines

7 Pit privy

10 Livestock pens

14 Abandoned water well

2 Sewer lines

5 Cess pool

8 Sewage lagoon

11 Fuel storage

15 Oil well/Gas well

3 Watertight sewer lines 6 Seepage pit

9 Feedyard

12 Fertilizer storage

16 Other (specify below)

13 Insecticide storage

Direction from well?

How many feet?

FROM TO LITHOLOGIC LOG FROM TO PLUGGING INTERVALS

0 5 Clay, silty, sl. sandy, Brown

5 13 Sand, vf-c w/f-m gravel (fill), Brown

13 17 Sand, vf-m, Lt. Brown to Red Brown (iron sta)

17 21 Sand, f-c w/f gravel, Light Brown

21 25 Sand, vf-c, v. silty, Light Brown

25 36 Sand, vf-c w/f to tr. m gravel, Lt. Brown

AS1, Flushmount

7 CONTRACTOR'S OR LANDOWNER'S CERTIFICATION: This water well was **(1)** constructed, (2) reconstructed, or (3) plugged under my jurisdictionand was completed on (mo/day/year) **8/23/2010** and this record is true to the best of my knowledge and belief.Kansas Water Well Contractor's License No. **527** This Water Well Record was completed on (mo/day/yr) **9/20/2010**

under the business name of

GeoCore, Inc.

by (signature)