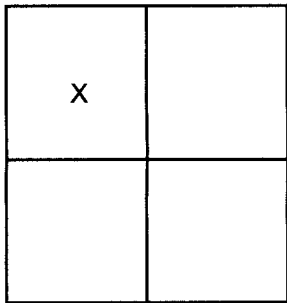


LOCATION OF WATER WELL: RENO COUNTY	Fraction NC-NW	Section Number 09	Township Number 23 SOUTH	Range Number 06 WEST																											
Distance and direction from nearest town or city street address of well if located within city? APPROXIMATELY 1.25 MILES WEST OF HUTCHINSON, KS																															
WATER WELL OWNER: LARRY B MORGAN TRUST LARRY B MORGAN TTEE RR#, St. Address, Box #: 2017 MARNEL ROAD HOUSTON, TX 77055 City, State, ZIP Code:																															
MARK WELL'S LOCATION WITH AN "X" IN SECTION BOX <div style="text-align: center;">  </div>		DEPTH OF WELL 43.3 ft. WELL'S STATIC WATER LEVEL 9.8 ft. WELL WAS USED AS: <table style="width:100%;"> <tr> <td>1 Domestic</td> <td>5 Public Water Supply</td> <td>9 Dewatering</td> </tr> <tr> <td>2 Irrigation</td> <td>6 Oil Field Water Supply</td> <td>10 Monitoring Well</td> </tr> <tr> <td>3 Feedlot</td> <td>7 Lawn and Garden Only</td> <td>11 Injection Well</td> </tr> <tr> <td>4 Industrial</td> <td>8 Air Conditioning</td> <td>12 Other</td> </tr> </table> Was a chemical/bacteriological sample submitted to Department? Yes <input type="checkbox"/> No <input checked="" type="checkbox"/> If yes, mo/day/yr sample was submitted : / / Water Well Disinfected: Yes <input checked="" type="checkbox"/> No <input type="checkbox"/>			1 Domestic	5 Public Water Supply	9 Dewatering	2 Irrigation	6 Oil Field Water Supply	10 Monitoring Well	3 Feedlot	7 Lawn and Garden Only	11 Injection Well	4 Industrial	8 Air Conditioning	12 Other															
1 Domestic	5 Public Water Supply	9 Dewatering																													
2 Irrigation	6 Oil Field Water Supply	10 Monitoring Well																													
3 Feedlot	7 Lawn and Garden Only	11 Injection Well																													
4 Industrial	8 Air Conditioning	12 Other																													
TYPE OF BLANK CASING USED: <table style="width:100%;"> <tr> <td>1 Steel</td> <td>3 RMP (SR)</td> <td>5 Wrought</td> <td>7 Fiberglass</td> <td>9 Other</td> </tr> <tr> <td>2 PVC</td> <td>4 ABS</td> <td>6 Asbestos-Cement</td> <td>8 Concrete Tile</td> <td></td> </tr> </table> Blank casing diameter 19.0 in. Was casing pulled? Yes <input type="checkbox"/> No <input checked="" type="checkbox"/> if yes, how much 0.0 ft bls Casing height above or below land surface 3 feet.					1 Steel	3 RMP (SR)	5 Wrought	7 Fiberglass	9 Other	2 PVC	4 ABS	6 Asbestos-Cement	8 Concrete Tile																		
1 Steel	3 RMP (SR)	5 Wrought	7 Fiberglass	9 Other																											
2 PVC	4 ABS	6 Asbestos-Cement	8 Concrete Tile																												
GROUT PLUG MATERIAL: 1 Neat cement 2 Cement grout 3 Bentonite 4 Other Grout Plug Intervals: From 10 ft. to 3 ft. What is the nearest source of possible contamination: <table style="width:100%;"> <tr> <td>1 Septic tank</td> <td>6 Seepage pit</td> <td>11 Fuel Storage</td> <td>16 Other</td> </tr> <tr> <td>2 Sewer lines</td> <td>7 Pit privy</td> <td>12 Fertilizer storage</td> <td></td> </tr> <tr> <td>3 Watertight sewer lines</td> <td>8 Sewage lagoon</td> <td>13 Insecticide storage</td> <td></td> </tr> <tr> <td>4 Lateral lines</td> <td>9 Feedyard</td> <td>14 Abandoned water well</td> <td></td> </tr> <tr> <td>5 Cess Pool</td> <td>10 Livestock pens</td> <td>15 Oil well / Gas well</td> <td></td> </tr> </table> Direction from well? How many feet? None within ¼ mile.					1 Septic tank	6 Seepage pit	11 Fuel Storage	16 Other	2 Sewer lines	7 Pit privy	12 Fertilizer storage		3 Watertight sewer lines	8 Sewage lagoon	13 Insecticide storage		4 Lateral lines	9 Feedyard	14 Abandoned water well		5 Cess Pool	10 Livestock pens	15 Oil well / Gas well								
1 Septic tank	6 Seepage pit	11 Fuel Storage	16 Other																												
2 Sewer lines	7 Pit privy	12 Fertilizer storage																													
3 Watertight sewer lines	8 Sewage lagoon	13 Insecticide storage																													
4 Lateral lines	9 Feedyard	14 Abandoned water well																													
5 Cess Pool	10 Livestock pens	15 Oil well / Gas well																													
<table border="1" style="width:100%; border-collapse: collapse;"> <tr> <th style="width:15%;">FROM</th> <th style="width:15%;">TO</th> <th style="width:70%;">PLUGGING MATERIALS</th> </tr> <tr> <td>43.3</td> <td>10</td> <td>CLEAN, COURSE SAND</td> </tr> <tr> <td>10</td> <td>3</td> <td>CEMENT GROUT</td> </tr> <tr> <td>3</td> <td>0</td> <td>TOPSOIL</td> </tr> <tr><td> </td><td> </td><td> </td></tr> <tr><td> </td><td> </td><td> </td></tr> <tr><td> </td><td> </td><td> </td></tr> <tr><td> </td><td> </td><td> </td></tr> <tr><td> </td><td> </td><td> </td></tr> </table>		FROM	TO	PLUGGING MATERIALS	43.3	10	CLEAN, COURSE SAND	10	3	CEMENT GROUT	3	0	TOPSOIL																<div style="text-align: right;"> RECEIVED FEB 25 2011 Equus Beds Groundwater Management District No. 2 Partial well plugging witnessed by David Randolph, GMD2 staff, on 8/12/10. Well plugging completed on 8/26/10. </div>		
FROM	TO	PLUGGING MATERIALS																													
43.3	10	CLEAN, COURSE SAND																													
10	3	CEMENT GROUT																													
3	0	TOPSOIL																													
CONTRACTOR'S OR LANDOWNER'S CERTIFICATION: This water well was plugged under my jurisdiction and was completed on (mo/day/year) 8 / 26 / 2010 and this record is true to the best of my knowledge and belief. Kansas Water Well Contractor's License No. NA under the business name of by (signature) <i>Larry B. Morgan</i> Larry B. Morgan, owner																															
INSTRUCTIONS: Use typewriter or ball point pen. Please press firmly and print clearly. Please fill in blanks, and underline or circle the correct answers. Send top three copies to Kansas Department of Health and Environment, Bureau of Water, Topeka, Kansas 66620-0001. Telephone: 913/296-3565. Send one to Water Well Owner and retain one for your records.																															