

WATER WELL RECORD

Form WWC-5

Division of Water Resources App. No.


Well ID

MW9

Original Record Correction Change in Well Ust

1 LOCATION OF WATER WELL: County Reno Fraction NE 1/4 SE 1/4 SE 1/4 NE 1/4 Section Number 35 Township Number T 23 S Range Number R 6 E W

2 WELL OWNER: Last Name: Burks First: Street or Rural Address where well is located (if unknown, distance and direction from nearest town or intersection): If at owner's address, check here: X

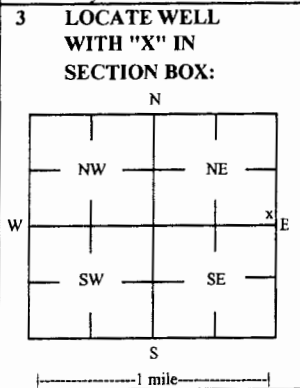

4 DEPTH OF COMPLETED WELL: 33.82 ft Depth(s) Groundwater Encountered: 1) 33.82 ft 2) ft 3) ft or 4) Dry Well WELL'S STATIC WATER LEVEL: 22.38 ft

5 Latitude: 38.00775 (decimal degrees) Longitude: 97.94084 (decimal degrees) Horizontal Datum: X WGS 84 NAD 83 NAD 27

6 Elevation 1538.62 ft Ground Level X TOC Source: X Land Survey GPS Topographic Map

7 WELL WATER TO BE USED AS: 1 Domestic: Household Lawn & Garden Livestock Irrigation Feedlot Industrial 2 Public Water Supply: well ID 3 Dewatering: how many wells? 4 Aquifer Recharge: well ID 5 Monitoring: well ID MW9 6 Environmental Remediation: well ID 7 Air Sparge 8 Soil Vapor Extractor 9 Recovery 10 Injection 11 Oil Field Water Supply: lease 12 Test Hole: well ID 13 Cased Uncased Geotechnical 14 Geothermal: How many bores? 15 a) Closed Loop Horizontal Vertical b) Open Loop Surface Discharge Inj. of Water 16 Other (specify):

Was a chemical/bacteriological sample submitted to KDHE? Yes No X No If yes, date sample was submitted: Water well disinfected? Yes No X No

8 TYPE OF CASING USED: Steel PVC Other CASING JOINTS: Glued Clamped Welded X Threaded Casing diameter 2 in. to 13.82 ft Diameter in. to ft Diameter in. to ft Casing height above land surface -0.29 in. Weight lbs./ft. Well thickness or gauge No TYPE OF SCREEN OR PERFORATION MATERIAL: Steel Stainless Steel Fiberglass PVC Other (Specify) SCREEN OR PERFORATION OPENINGS ARE: Continuous Slot X Mill Slot Gauze Wrapped Torch Cut Drilled Holes Other (Specify) Louvered Shutter Key Punched Wire Wrapped Saw Cut None (Open Hole) SCREEN-PERFORATED INTERVALS: From 13.82 ft. to 33.82 ft. From ft. to ft. From ft. to ft. GRAVEL PACK INTERVALS: From 13 ft. to 35 ft. From ft. to ft. From ft. to ft.

9 GROUT MATERIAL: Neat cement Cement grout X Bentonite X Other Concrete: 0-0.5' Grout intervals: From 0.5 ft. to 35 ft. From ft. to ft. From ft. to ft.

Nearest source of possible contamination: Septic Tank Lateral Lines Pit Privy Livestock Pens Insecticide Storage Sewer Lines Cess Pool Sewage Lagoon X Fuel Storage Abandoned Water Well Watertight Sewer Lines Seepage Pit Feedyard Fertilizer Storage Oil Well / Gas Well Other (Specify) Direction from well? NW Distance from well? ~160 ft

Table with 6 columns: FROM, TO, LITHOLOGIC LOG, FROM, TO, LITHO. LOG (cont.) or PLUGGING INTERVALS. Rows include soil types like Topsoil & gravel, Orange brown silty clay, etc.

11 CONTRACTOR'S OR LANDOWNER'S CERTIFICATION: This water well was X constructed, reconstructed or plugged under my jurisdiction and was completed on (mo-day-year) 1/6/16 and this record is true to the best of my knowledge and belief. Kansas Water Well Contractor's License No. 757 This Water Well Record was completed on (mo-day-year) 2/18/16 under the business name of Larsen & Associates, Inc. Signature

TRITERRA

LAND SERVICES

P.O. Box 546
Clearwater, Kansas 67026
Cell (316) 648-3617 Fax (620) 584-4371
Email: triterrals@yahoo.com

SURVEYING OF MONITORING WELLS
CENTRAL TRAVEL PLAZA, LLC
SOUTH HUTCHINSON, KANSAS

The above site is located in Section 35, Township 23 South, Range 6 West of the Sixth Principal Meridian, Reno County, Kansas. The Northeast corner of Sections 35 was assigned coordinates of 5280.00 North and 00.00 West.

The vertical control is the previously established control point, described as a chiseled "X" on top of the east end of the RCP under the site entrance.

The Latitude and Longitude were recorded from a GPS unit. The site is located on the 7.5' quad map titled "Hutchinson".

| ID | NORTH | WEST | LATITUDE | LONGITUDE | ELEVATION |
|------------------------|---------|--------|----------|-----------|----------------------------|
| NE CORNER 35-23S-6W | 5280.00 | 00.00 | | | |
| CP | 3329.48 | 197.19 | 38.00783 | 97.94093 | 1536.62 |
| MW-9 NE SE SE NE | 3296.39 | 166.51 | 38.00775 | 97.94084 | RIM 1538.91 TOC 1538.62 |

