


WATER WELL RECORD Form WWC-5 1373546

1373546

Division of Water
Resources App. No.

Well ID

☐ Original Record ☐ Correction ☐ Change in Well Use[illegible]

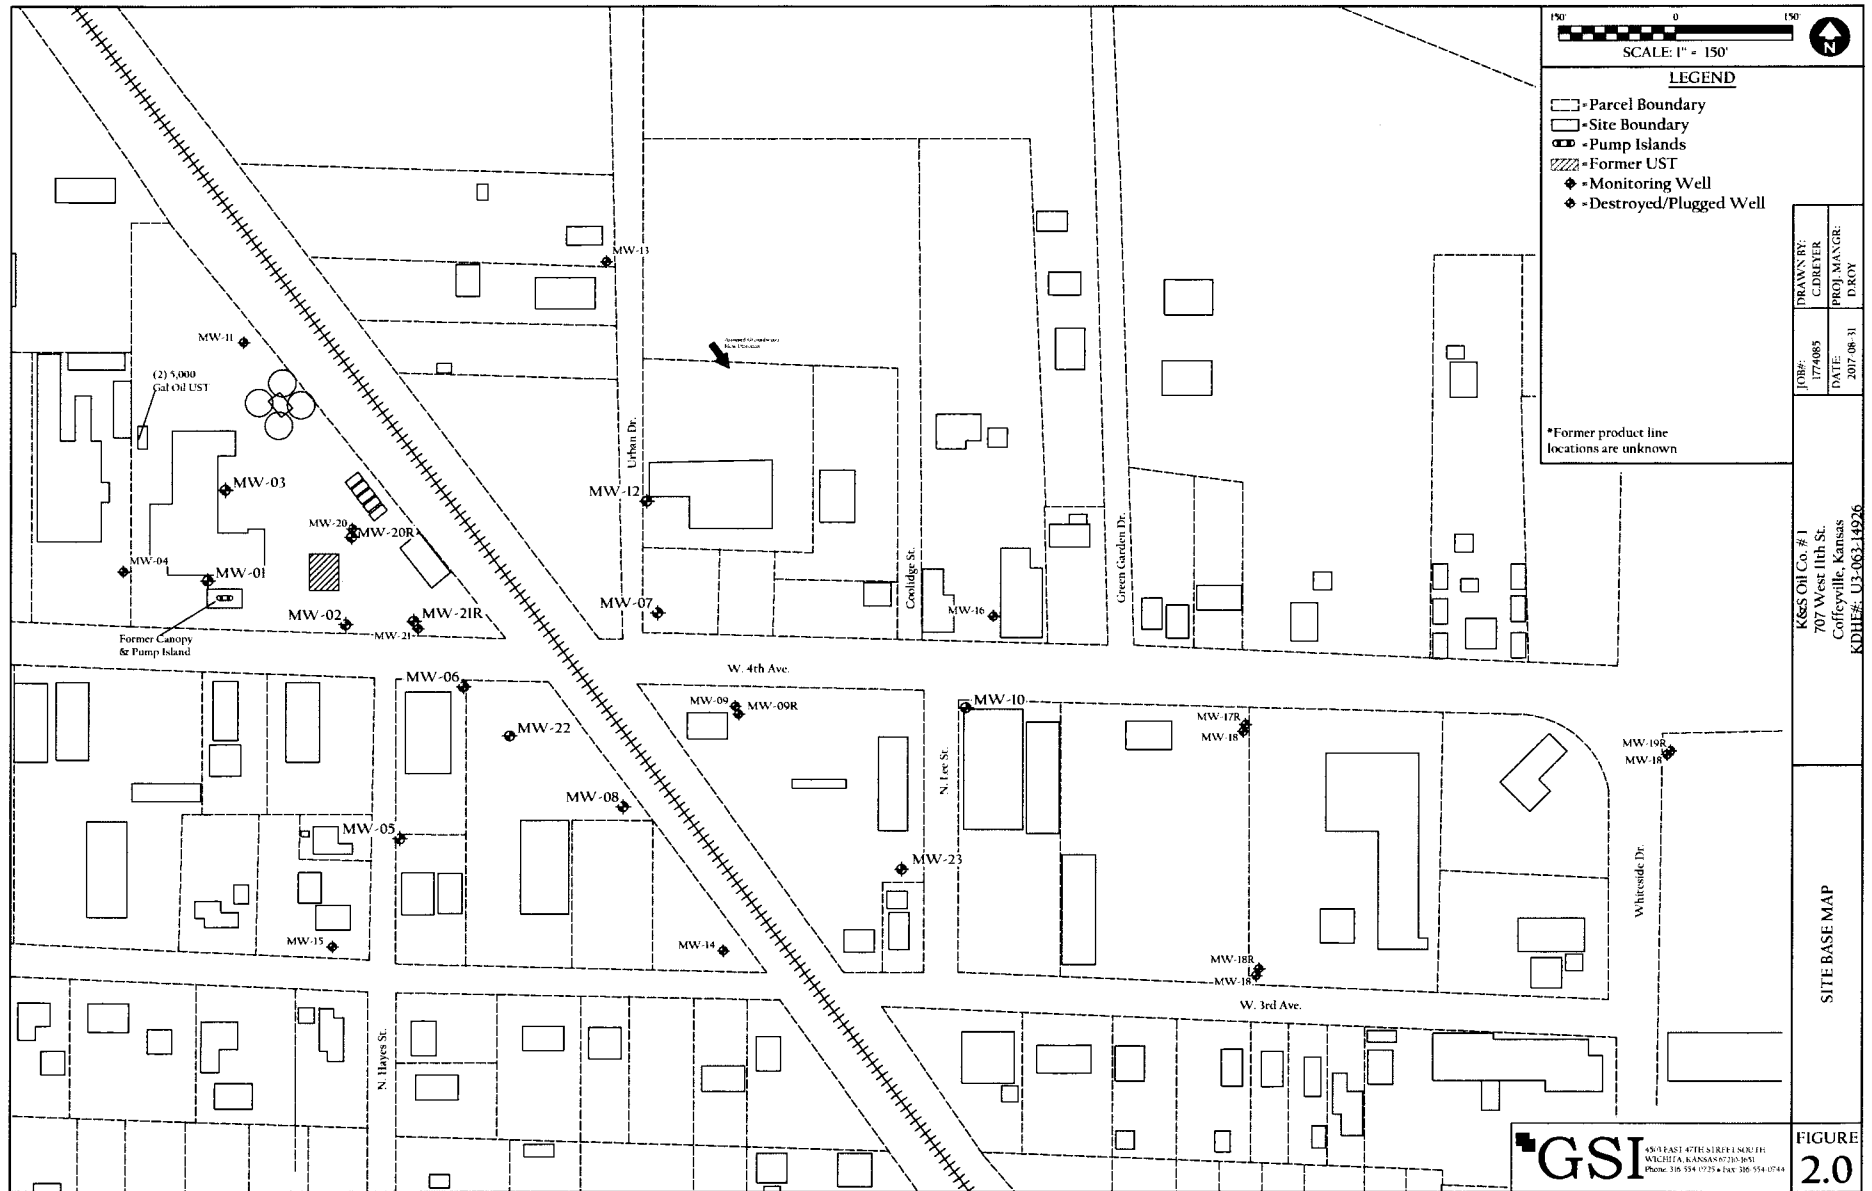

RINO CO. NW NE NW 14 - 20 - 0 W