

WATER WELL RECORD Form WWC-5

Original Record Correction Change in Well Use

Division of Water Resources App. No.


20180012

Well ID

#1

1 LOCATION OF WATER WELL: County: Reno Fraction 1/4 SW 1/4 SW 1/4 NE 1/4 Section Number 14 Township Number T 23 S Range Number R 6 E W

2 WELL OWNER: Last Name: City of Hutchinson Address: PO Box 1567 City: Hutchinson State: Ks ZIP: 67504-1567 Street or Rural Address where well is located: From 1st and Whiteside in Hutchinson 450ft east - 405ft south

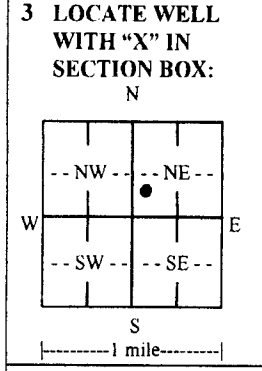

3 LOCATE WELL WITH 'X' IN SECTION BOX: 4 DEPTH OF COMPLETED WELL: 50 ft. Depth(s) Groundwater Encountered: 1) ... 2) ... 3) ... 4) Dry Well WEL'S STATIC WATER LEVEL: 14 ft. Source for Latitude/Longitude: GPS (unit make/model: Garmin 62S)

5 Latitude: 38.05227 Longitude: 097.94779 Horizontal Datum: NAD 83 NAD 27 Source for Latitude/Longitude: GPS (unit make/model: Garmin 62S)

6 Elevation: 1533 ft. Source: GPS

7 WELL WATER TO BE USED AS: 1. Domestic: Household, Lawn & Garden, Livestock, Irrigation, Feedlot, Industrial. 2. Public Water Supply, Dewatering, Aquifer Recharge, Monitoring, Environmental Remediation, Air Sparge, Soil Vapor Extraction, Recovery, Injection, Oil Field Water Supply, Test Hole, Geothermal, Open Loop, Surface Discharge, Inj. of Water, Other (specify)

Was a chemical/bacteriological sample submitted to KDHE? Yes No If yes, date sample was submitted: Water well disinfected? Yes No

8 TYPE OF CASING USED: Steel PVC Other CASING JOINTS: Glued Clamped Welded Threaded Casing diameter 10 in. to 15 ft., Diameter 14 in. to SCH40 lbs./ft. Wall thickness or gauge No. 4.13 TYPE OF SCREEN OR PERFORATION MATERIAL: Steel Stainless Steel Fiberglass PVC Other SCREEN OR PERFORATION OPENINGS ARE: Continuous Slot Mill Slot Gauze Wrapped Torch Cut Drilled Holes Other Louvered Shutter Key Punched Wire Wrapped Saw Cut None (Open Hole) SCREEN-PERFORATED INTERVALS: From 15 ft. to 50 ft., From 50 ft. to GRAVEL PACK INTERVALS: From 50 ft. to 5 ft., From

9 GROUT MATERIAL: Neat cement Cement grout Bentonite Other Grout Intervals: From 5 ft. to 0 ft., From Nearest source of possible contamination: Septic Tank Lateral Lines Pit Privy Livestock Pens Insecticide Storage Sewer Lines Cess Pool Sewage Lagoon Fuel Storage Abandoned Water Well Watertight Sewer Lines Seepage Pit Feedyard Fertilizer Storage Oil Well/Gas Well Other (Specify) South Distance from well? 10 ft.

Table with columns: FROM, TO, LITHOLOGIC LOG, FROM, TO, LITHO. LOG (cont.) or PLUGGING INTERVALS. Rows: 0-5 Top soil, 5-12 Brown clay-sand mix, 12-53 Med.-fine sand, Notes:

11 CONTRACTOR'S OR LANDOWNER'S CERTIFICATION: This water well was constructed, reconstructed, or plugged under my jurisdiction and was completed on (mo-day-year) 1/9/2018 and this record is true to the best of my knowledge and belief. Kansas Water Well Contractor's License No. 134. This Water Well Record was completed on (mo-day-year) 1/22/2018 under the business name of Rosencrantz-Bemis Ent. Signature