

WATER WELL PLUGGING RECORD Form WWC-5P

Well # 2 ID NO. 2018000012
 KSA 82a-1212


1 LOCATION OF WATER WELL: Fraction 1/4 S 1/4 SW 1/4 NE 1/4 Section Number 14 Township Number T 23 S Range Number 6 E W
 County: Reno

Street/Rural Address of Well Location: if unknown, distance & direction from nearest town or intersection: If at owner's address, check here From 1st & Whiteside in Hutchinson
450ft east - 405ft south

Global Positioning Systems (GPS) information:
 Latitude: 38.05210 (in decimal degrees)
 Longitude: 097.94781 (in decimal degrees)
 Elevation: 1539
 Horizontal Datum: WGS84, NAD83, NAD27
 Collection Method:

2 WATER WELL OWNER: City of Hutchinson
 RR#, St. Address, Box #: PO Bx.1567
 City, State ZIP Code: Hutchinson, Kansas 67504-1567

GPS unit (Make/Model: Garmin 62S)
 Digital Map/Photo, Topographic Map, Land Survey
 Est. Accuracy: < 3 m, 3-5 m, 5-15 m, > 15 m

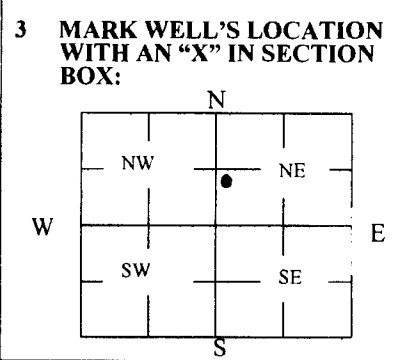

4 DEPTH OF WELL 55 ft.
 WELL'S STATIC WATER LEVEL 17 ft.
 WELL WAS USED AS:
 Domestic Public Water Supply Dewatering
 Irrigation Oil Field Water Supply Monitoring
 Feedlot Domestic (Lawn & Garden) Injection Well
 Industrial Air Conditioning Other _____
 Was a chemical/bacteriological sample submitted to Department? Yes No

5 TYPE OF BLANK CASING USED:
 Steel RMP (SR) Wrought Fiberglass Other (Specify below)
 PVC ABS Asbestos-Cement Concrete Tile

Blank casing diameter 10 in. Was casing pulled? Yes No If yes, how much 55ft
 Casing height above or below land surface _____ in.

6 GROUT PLUG MATERIAL: Neat cement Cement grout Bentonite Other Pea gravel & dirt
 Grout Plug Intervals: From 55 ft. to 20 ft., From 20 ft. to 4 ft., From 4 ft. to 0 ft.

What is the nearest source of possible contamination:
 Septic tank Seepage pit Fuel storage Other (specify below)
 Sewer lines Pit privy Fertilizer storage
 Watertight sewer lines Sewage lagoon Insecticide storage
 Lateral lines Feedyard Abandoned water well Oil well/Gas well
 Cess pool Livestock pens

Direction from well? North
 How many feet? 5

FROM	TO	PLUGGING MATERIALS	FROM	TO	PLUGGING MATERIALS
0	4	Dirt			
4	20	Hole plug			
20	55	Pea gravel			

7 CONTRACTOR'S OR LANDOWNER'S CERTIFICATION: This water well was plugged under my jurisdiction and was completed on (mo/day/year) 1/18/2018 and this record is true to the best of my knowledge and belief. Kansas Water Well Contractor's License No. 134. This Water Well Record was completed on (mo/day/year) 1/22/2018 under the business name of Rosencrantz-Bemis Ent. by (signature) [Signature]