

WATER WELL RECORD


Form WWC-5

Division of Water Resources App. No.

1 LOCATION OF WATER WELL: County: RENO Fraction: 1/4 NE 1/4 SW 1/4 NW 1/4 Section Number: 01 Township No. T23 S Range Number R06 E1W

Street/Rural Address of Well Location; if unknown, distance & direction from nearest town or intersection: If at owner's address, check here X Global Positioning System (GPS) information: Latitude: Longitude: Elevation: Datum: Collection Method: GPS unit (Make/Model): Digital Map/Photo, Topographic Map, Land Survey Est. Accuracy: <3 m, 3-5 m, 5-15 m, >15 m

2 WATER WELL OWNER: David Johnston RR#, Street Address, Box #: 410 W 25th City, State, ZIP Code: Hutchinson, KS 67502

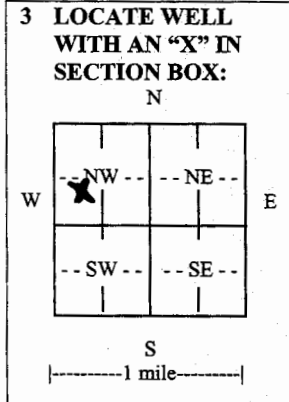

4 DEPTH OF COMPLETED WELL: 32 ft. Depth(s) Groundwater Encountered (1) 17 ft. (2) ft. (3) ft. WELL'S STATIC WATER LEVEL: 17 ft. below land surface measured on mo/day/yr. 4-26-18 Pump test data: Well water was 17 ft. after 12 hours pumping. 25 gpm EST. YIELD: 9 gpm Well water was 17 ft. after 12 hours pumping. 25 gpm Bore Hole Diameter: 9 in. to 17 ft., and in. to ft. WELL WATER TO BE USED AS: Domestic, Feedlot, Oil field water supply, Dewatering, Other (Specify below) Irrigation, Industrial, Domestic-lawn & garden, Monitoring well Was a chemical/bacteriological sample submitted to Department? Yes X No If yes, mo/day/yr sample was submitted. Water well disinfected? X Yes No

5 TYPE OF CASING USED: Steel, PVC X, Other CASING JOINTS: Glued X, Clamped, Welded, Threaded Casing diameter: 5 in. to 32 ft., Diameter in. to ft., Diameter in. to ft. Casing height above land surface: 32 in., Weight 2.29 lbs./ft., Wall thickness or gauge No. 160 TYPE OF SCREEN OR PERFORATION MATERIAL: Steel, Stainless Steel, PVC X, Other (Specify) Brass, Galvanized Steel, None used (open hole) SCREEN OR PERFORATION OPENINGS ARE: Continuous slot, Mill slot, Gauze wrapped, Torch cut, Drilled holes, None (open hole) Louvered shutter, Key punched, Wire wrapped, Saw cut X, Other (specify) SCREEN-PERFORATED INTERVALS: From 22 ft. to 32 ft., From ft. to ft., From ft. to ft. GRAVEL PACK INTERVALS: From 17 ft. to 32 ft., From ft. to ft., From ft. to ft.

6 GROUT MATERIAL: Neat cement, Cement grout, Bentonite X, Other Grout Intervals: From 17 ft. to 17 ft., From ft. to ft., From ft. to ft. What is the nearest source of possible contamination: Septic tank, Lateral lines, Pit privy, Livestock pens, Insecticide storage, Other (specify below) Sewer lines, Cesspool, Sewage lagoon, Fuel storage, Abandoned water well Watertight sewer lines X, Seepage pit, Feedyard, Fertilizer storage, Oil well/gas well Direction from well: East Distance from well: 35

Table with columns: FROM, TO, LITHOLOGIC LOG, FROM, TO, LITHO. LOG (cont.) or PLUGGING INTERVALS. Rows: 0-8 Black Top Soil, 8-17 Fine Sand, 17-32 Pleasure gravel

7 CONTRACTOR'S OR LANDOWNER'S CERTIFICATION: This water well was constructed X, reconstructed, or plugged under my jurisdiction and was completed on (mo/day/year) 4-20-18 and this record is true to the best of my knowledge and belief. Kansas Water Well Contractor's License No. 755 This Water Well Record was completed on (mo/day/year) 4-26-18 under the business name of Wilson Water Systems by (signature) Eric Wilson

INSTRUCTIONS: Use typewriter or ball point pen. PLEASE PRESS FIRMLY and PRINT clearly. Please fill in blanks and check the correct answers. Send three copies (white, blue, pink) to Kansas Department of Health and Environment, Bureau of Water, Geology Section, 1000 SW Jackson St., Suite 420, Topeka, Kansas 66612-1367. Telephone 785-296-5524. Send one copy to WATER WELL OWNER and retain one for your records. Include fee of \$5.00 for each constructed well. Visit us at http://www.kdheks.gov/waterwell/index.html.