

# WATER WELL PLUGGING RECORD Form WWC-5P

KSA 82a-1212 ID NO.

13953,9111,21422

1 LOCATION OF WATER WELL: Fraction NE 1/4 N 1/4 SW 1/4 SW 1/4 Section Number 22 Township Number T 23 S Range Number 6 ☐ E ☒ W

Street/Rural Address of Well Location; if unknown, distance & direction from nearest town or intersection: If at owner's address, check here ☒ ONEOK facility


## Global Positioning Systems (GPS) information:

Latitude: 38.03107 (in decimal degrees)  
Longitude: 097.97439 (in decimal degrees)  
Elevation: 1541  
Horizontal Datum: ☐ WGS84, ☐ NAD83, ☒ NAD27  
Collection Method:

2 WATER WELL OWNER: ONEOK Hydrocarbon, L.P.  
RR#, St. Address, Box #: 1910 S. Broadacres Rd.  
City, State ZIP Code: Hutchinson, Ks. 67501-9627

☐ GPS unit (Make/Model: Garmin 62S)  
☐ Digital Map/Photo, ☒ Topographic Map, ☐ Land Survey  
Est. Accuracy: ☐ < 3 m, ☒ 3-5 m, ☐ 5-15 m, ☐ > 15 m

3 MARK WELL'S LOCATION WITH AN "X" IN SECTION BOX:

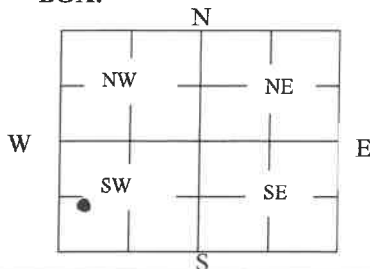

4 DEPTH OF WELL 50'9" ft.

WELL'S STATIC WATER LEVEL 28'9" ft

WELL WAS USED AS:

☐ Domestic ☐ Public Water Supply ☐ Dewatering  
☐ Irrigation ☐ Oil Field Water Supply ☐ Monitoring  
☐ Feedlot ☐ Domestic (Lawn & Garden) ☐ Injection Well  
☐ Industrial ☐ Air Conditioning ☒ Other Supply

Was a chemical/bacteriological sample submitted to Department? Yes ☐ No ☒

5 TYPE OF BLANK CASING USED:

☒ Steel ☐ RMP (SR) ☐ Wrought ☐ Fiberglass ☐ Other (Specify below)  
☐ PVC ☐ ABS ☐ Asbestos-Cement ☐ Concrete Tile

Blank casing diameter 10 in. Was casing pulled? Yes ☐ No ☒ If yes, how much \_\_\_\_\_  
Casing height above or below land surface 36 in.

6 GROUT PLUG MATERIAL: ☐ Neat cement ☐ Cement grout ☒ Bentonite ☒ Other Top soil, gravel

Grout Plug Intervals: From 0 ft. to 3 ft., From 3 ft. to 28 ft., From 28 ft. to 50'9" ft.

What is the nearest source of possible contamination:

☐ Septic tank ☐ Seepage pit ☐ Fuel storage ☒ Other (specify below)  
☐ Sewer lines ☐ Pit privy ☐ Fertilizer storage New well  
☐ Watertight sewer lines ☐ Sewage lagoon ☐ Insecticide storage  
☐ Lateral lines ☐ Feedyard ☐ Abandoned water well  
☐ Cess pool ☐ Livestock pens ☐ Oil well/Gas well  
Direction from well? North  
How many feet? 15'

FROM	TO	PLUGGING MATERIALS	FROM	TO	PLUGGING MATERIALS
0	3	Top soil			
3	28	Bentonite			
28	50'9"	Gravel			

7 CONTRACTOR'S OR LANDOWNER'S CERTIFICATION: This water well was plugged under my jurisdiction and was completed on (mo/day/year) 5/8/2018 and this record is true to the best of my knowledge and belief. Kansas Water Well Contractor's License No. 134 This Water Well Record was completed on (mo/day/year) 5/14/2018 under the business name of Rosencrantz-Bemis Ent. by (signature) C. J. Bunnell

Send one white copy to Kansas Department of Health & Environment, Geology Section, 1000 SW Jackson Street, Ste. 420, Topeka, KS 66612-1367. Send one copy to WATER WELL OWNER and retain one for your records.

Visit us at <http://www.kdheks.gov/waterwell/index.html> Telephone 785-296-5524.

KSA82a-1212

Revised 1/20/2015