


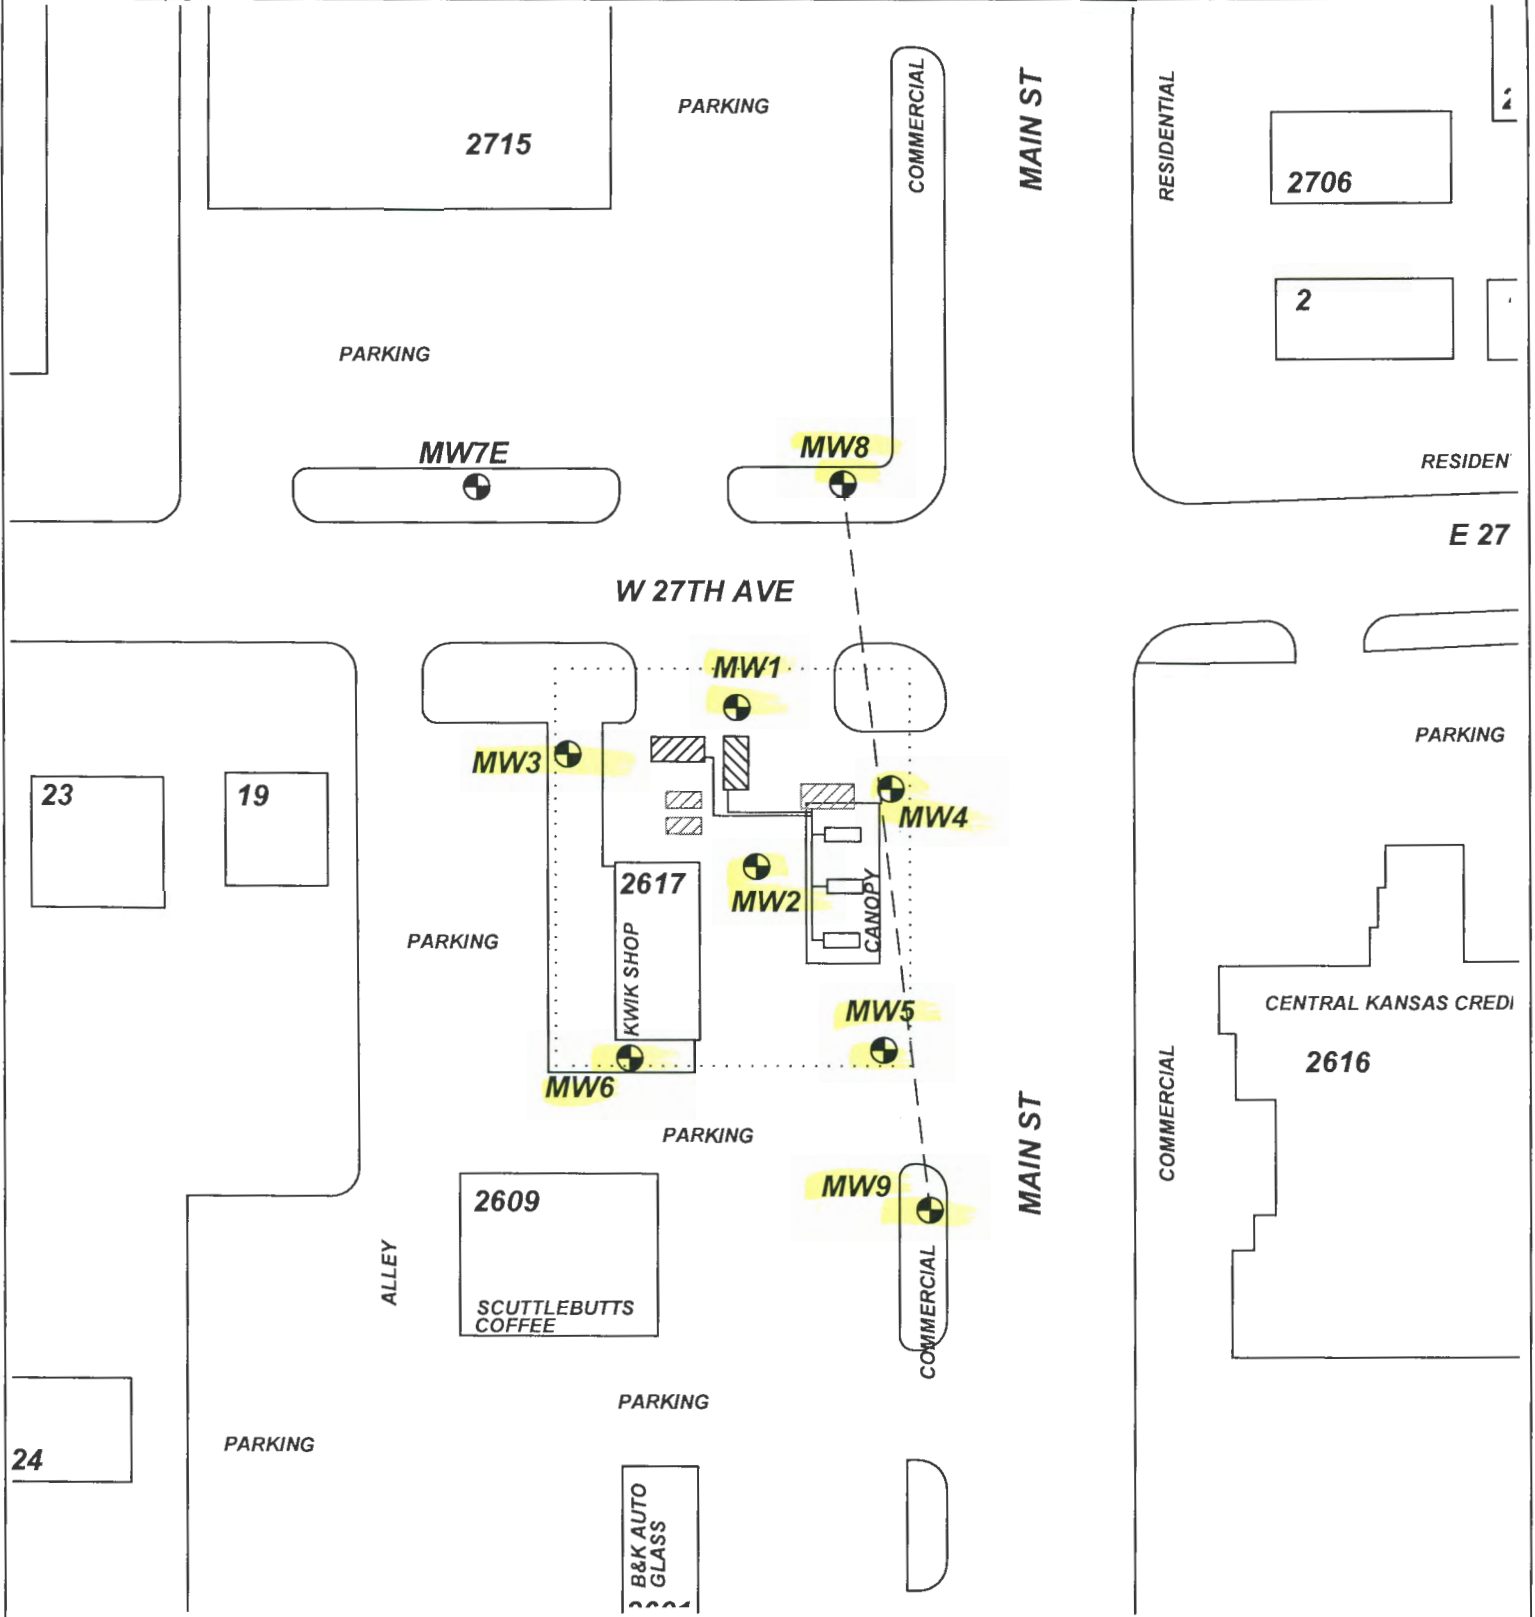

KEND

SE SIDE DW

6



PROJECT: **KWIK SHOP #764**

ADDRESS: **2617 N. MAIN**

LOCATION: **HUTCHINSON, KS**

DRAWN BY: **B. STALNAKER** DATE: **5/17/18**

REVISED BY: **B. STALNAKER** DATE: **10/16/18**


AEI JOB # **TF513** KDHE JOB # **U2-078-15068**

TITLE:

**ASSOCIATED ENVIRONMENTAL INC.**

LEGEND:

- = CURRENT BASIN AND PUMP ISLANDS/LINES
- = FORMER BASINS (FILLED IN PLACE)
- = MONITORING WELL
- = SUBJECT PROPERTY

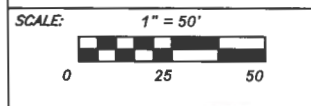

NOTES:  
No basements observed within 500'.