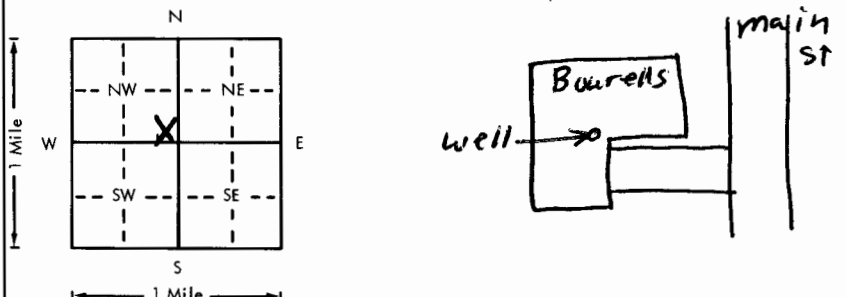


USE TYPEWRITER OR BALL
POINT PEN-PRESS FIRMLY,
PRINT CLEARLY.

WATER WELL RECORD
KSA 82a-1201-1215

Kansas Department of Health and
Environment-Division of Environment
(Water well Contractors)
Topeka, Kansas 66620

1. Location of well:	County Reno	Fraction SE 1/4 SE 1/4 NW 1/4	Section number 1	Township number T 23 S	Range number R 6 E
2. Distance and direction from nearest town or city: Street address of well location if in city:	2411 N. Main Hutchinson		3. Owner of well: Bouren's Floor Covering R.R. or street: 2411 N. Main City, state, zip code: Hutchinson Kan 67501		
4. Locate with "X" in section below:	Sketch map:		6. Bore hole dia. 9 in. Completion date 5-11-76 Well depth 30 ft.		
			7. <input type="checkbox"/> Cable tool <input type="checkbox"/> Rotary <input type="checkbox"/> Driven <input checked="" type="checkbox"/> Dug <input type="checkbox"/> Hollow rod <input type="checkbox"/> Jetted <input checked="" type="checkbox"/> Bored <input type="checkbox"/> Reverse rotary		
5. Type and color of material	From	To	8. Use: <input type="checkbox"/> Domestic <input type="checkbox"/> Public supply <input type="checkbox"/> Industry <input type="checkbox"/> Irrigation <input checked="" type="checkbox"/> Air conditioning <input type="checkbox"/> Stock <input type="checkbox"/> Lawn <input type="checkbox"/> Oil field water <input type="checkbox"/> Other		
brown sandy soil	0	3	9. Casing: Material Plas Height: above or below Threaded <input type="checkbox"/> Welded blue Surface 13 in. RMP <input checked="" type="checkbox"/> PVC <input type="checkbox"/> Weight <input type="checkbox"/> lbs./ft. Dia. 6 in. to 30 ft. depth Wall Thickness: inches or Dia. <input type="checkbox"/> in. to <input type="checkbox"/> ft. depth gage No. 1175		
brown sandy clay	3	8	10. Screen: Manufacturer's name J & L Type RMP Dia. 6" Slot/gauze 1/8 hole Length 70" Set between 20 ft. and 30 ft. ft. and ft.		
fine sand	8	11	Gravel pack? NO Size range of material		
fine gravel	11	13	11. Static water level: <input type="checkbox"/> mo./day/yr. 14 ft. below land surface Date 5-11-76		
medium gravel	13	30	12. Pumping level below land surfaces: 14 1/2 ft. after 1 hrs. pumping 15 g.p.m. ft. after hrs. pumping g.p.m. Estimated maximum yield 75 g.p.m.		
			13. Water sample submitted: <input type="checkbox"/> Yes <input checked="" type="checkbox"/> No Date		
			14. Well head completion: <input type="checkbox"/> Pitless adapter 12 Inches above grade		
			15. Well grouted? yes With: <input checked="" type="checkbox"/> Neat cement <input type="checkbox"/> Bentonite <input type="checkbox"/> Concrete Depth: From 2 ft. to 13 ft.		
			16. Nearest source of possible contamination: Storm Drain ft. 60 Direction E Type Drain Well disinfected upon completion? <input type="checkbox"/> Yes <input checked="" type="checkbox"/> No		
			17. Pump: <input checked="" type="checkbox"/> Not installed Manufacturer's name Model number HP Volts Length of drop pipe ft. capacity g.p.m. Type: <input type="checkbox"/> Submersible <input type="checkbox"/> Turbine <input type="checkbox"/> Jet <input type="checkbox"/> Reciprocating <input type="checkbox"/> Centrifugal <input type="checkbox"/> Other		
18. Elevation:	19. Remarks:		20. Water well contractor's certification: This well was drilled under my jurisdiction and this report is true to the best of my knowledge and belief. Price Water Well 193 Business name RR3 Hutchinson License No. Address John Davenport Date 8-11-76 Signed John Davenport Authorized representative		