

1 LOCATION OF WATER WELL:	Fraction	Section Number	Township Number	Range Number
County: <u>Reno</u>	<u>SE 1/4 NW 1/4 NW 1/4</u>	<u>2</u>	<u>T 23 S</u>	<u>R 6 E</u>


Distance and direction from nearest town or city street address of well if located within city?

302 W. 25th Hutchinson Kan

2 WATER WELL OWNER:	Board of Agriculture, Division of Water Resources
RR#, St. Address, Box # :	Application Number:
City, State, ZIP Code :	

Bill Beardon302 W. 25thHutchinson Kan 67502

3 LOCATE WELL'S LOCATION WITH AN "X" IN SECTION BOX:	4 DEPTH OF COMPLETED WELL	ft. ELEVATION:
--	---------------------------	----------------

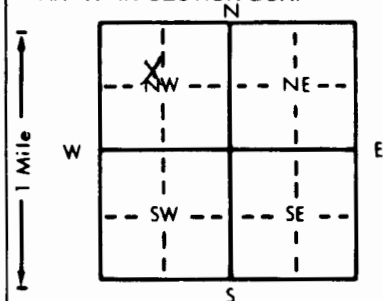

Depth(s) Groundwater Encountered	1	18	ft. 2		ft. 3		ft.
WELL'S STATIC WATER LEVEL	18	ft. below land surface measured on	mo/day/yr	8-5-91			
Pump test data: Well water was	19	ft. after	1	hours pumping	30	gpm	
Est. Yield	75	gpm: Well water was		ft. after		hours pumping	
Bore Hole Diameter	9	in. to	19	ft. and	6	in. to	36
WELL WATER TO BE USED AS:	5 Public water supply	8 Air conditioning	11 Injection well				
1 Domestic	3 Feedlot	6 Oil field water supply	9 Dewatering	12 Other (Specify below)			
2 Irrigation	4 Industrial	7 Lawn and garden only	10 Monitoring well				
Was a chemical/bacteriological sample submitted to Department? Yes	No	X	If yes, mo/day/yr sample was submitted				
Water Well Disinfected? Yes	X	No					

5 TYPE OF BLANK CASING USED:	5 Wrought iron	8 Concrete tile	CASING JOINTS: Glued	X	Clamped
1 Steel	3 RMP (SR)	6 Asbestos-Cement	9 Other (specify below)	Welded	
2 PVC	4 ABS	7 Fiberglass		Threaded	

Blank casing diameter	6	in. to	26	ft. Dia		in. to		ft. Dia		in. to		ft.
Casing height above land surface	12	in., weight		lbs./ft. Wall thickness or gauge No.	250							

TYPE OF SCREEN OR PERFORATION MATERIAL:	1 Steel	3 Stainless steel	5 Fiberglass	8 RMP (SR)	10 Asbestos-cement
2 Brass	4 Galvanized steel	6 Concrete tile	9 ABS	11 Other (specify)	12 None used (open hole)

SCREEN OR PERFORATION OPENINGS ARE:	5 Gauzed wrapped	8 Saw cut	11 None (open hole)
1 Continuous slot	3 Mill slot	6 Wire wrapped	9 Drilled holes
2 Louvered shutter	4 Key punched	7 Torch cut	10 Other (specify)

SCREEN-PERFORATED INTERVALS:	From	26	ft. to	36	ft. From		ft. to		ft.
GRAVEL PACK INTERVALS:	From		ft. to		ft. From		ft. to		ft.

6 GROUT MATERIAL:	1 Neat cement	2 Cement grout	3 Bentonite	4 Other					
Grout Intervals:	From	3	ft. to	19	ft. From		ft. to		ft.

What is the nearest source of possible contamination:	10 Livestock pens	14 Abandoned water well
1 Septic tank	11 Fuel storage	15 Oil well/Gas well
2 Sewer lines	12 Fertilizer storage	16 Other (specify below)
3 Watertight sewer lines	13 Insecticide storage	
4 Lateral lines	How many feet?	30
5 Cess pool		
6 Seepage pit		
7 Pit privy		
8 Sewage lagoon		
9 Feedyard		

FROM	TO	LITHOLOGIC LOG	FROM	TO	PLUGGING INTERVALS
0	2	Sandy soil			
2	11	Sandy clay			
11	16	fine sand			
16	20	fine gravel			
20	36	medium gravel			

7 CONTRACTOR'S OR LANDOWNER'S CERTIFICATION: This water well was	(1) constructed, (2) reconstructed, or (3) plugged under my jurisdiction and was completed on (mo/day/year)	8-5-91	and this record is true to the best of my knowledge and belief. Kansas Water Well Contractor's License No.	193	This Water Well Record was completed on (mo/day/yr)	5-10-92
under the business name of	Price Water well Serv.	by (signature)	John Davanport			