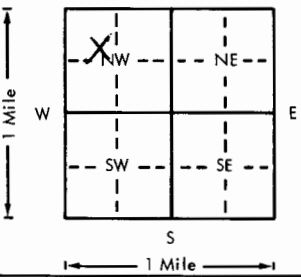
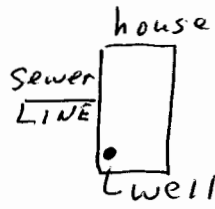


USE TYPEWRITER OR BALL
POINT PEN-PRESS FIRMLY,
PRINT CLEARLY.

WATER WELL RECORD
KSA 82a-1201-1215

Kansas Department of Health and
Environment-Division of Environment
(Water well Contractors)
Topeka, Kansas 66620

1. Location of well:		County Reno	Fraction SE 1/4 NW 1/4 NW 1/4	Section number 2	Township number T 23 S	Range number R 6 E
2. Distance and direction from nearest town or city: 2703 Nottingham Dr. Hutchinson Street address of well location if in city: Hutchinson				3. Owner of well: Ging Investment Co. R.R. or street: 1014 N. Main City, state, zip code: Hutchinson Kan. 67501		
4. Locate with "X" in section below:		Sketch map:		6. Bore hole dia. 9 in. Completion date 3-8-78 Well depth 25 ft.		
				7. Cable tool <input type="checkbox"/> Rotary <input type="checkbox"/> Driven <input checked="" type="checkbox"/> Dug <input type="checkbox"/> Hollow rod <input type="checkbox"/> Jetted <input checked="" type="checkbox"/> Bored <input type="checkbox"/> Reverse rotary		
5. Type and color of material				8. Use: <input type="checkbox"/> Domestic <input type="checkbox"/> Public supply <input type="checkbox"/> Industry <input type="checkbox"/> Irrigation <input type="checkbox"/> Air conditioning <input type="checkbox"/> Stock <input checked="" type="checkbox"/> Lawn <input type="checkbox"/> Oil field water <input type="checkbox"/> Other		
				9. Casing: Material Plas Height: above or below Threaded <input type="checkbox"/> Welded Glue Surface 12 in. RMP <input checked="" type="checkbox"/> PVC <input type="checkbox"/> Weight <input type="checkbox"/> lbs./ft. Dia. 6 in. to 25 ft. depth Wall Thickness: inches or Dia. <input type="checkbox"/> in. to <input type="checkbox"/> ft. depth gage No. 1175		
fine gravel medium gravel				10. Screen: Manufacturer's name JEL Type RMP Dia. 6" Slot/gauze 1/8 hole Length 10' Set between 15 ft. and 25 ft. ft. and ft. Gravel pack? no Size range of material		
				11. Static water level: 13 ft. below land surface Date 3-8-78 mo./day/yr.		
				12. Pumping level below land surfaces: 13 1/2 ft. after 2 hrs. pumping 25 g.p.m. ft. after hrs. pumping g.p.m. Estimated maximum yield 75 g.p.m.		
				13. Water sample submitted: X Yes <input type="checkbox"/> No Date		
				14. Well head completion: 12 floor Pitless adapter 12 inches above grade		
				15. Well grouted? yes With: <input type="checkbox"/> Neat cement <input type="checkbox"/> Bentonite <input checked="" type="checkbox"/> Concrete Depth: From 1 ft. to 8 ft.		
				16. Nearest source of possible contamination: Solid Sewer ft. 20 Direction N Type Well disinfected upon completion? <input type="checkbox"/> Yes <input checked="" type="checkbox"/> No		
				17. Pump: <input checked="" type="checkbox"/> Not installed Manufacturer's name Model number HP Volts Length of drop pipe ft. capacity g.p.m. Type: <input type="checkbox"/> Submersible <input type="checkbox"/> Turbine <input type="checkbox"/> Jet <input type="checkbox"/> Reciprocating <input type="checkbox"/> Centrifugal <input type="checkbox"/> Other		
18. Elevation:		19. Remarks:		20. Water well contractor's certification:		
Topography: <input type="checkbox"/> Hill <input type="checkbox"/> Slope <input type="checkbox"/> Upland <input checked="" type="checkbox"/> Valley		well in basement		This well was drilled under my jurisdiction and this report is true to the best of my knowledge and belief. Price Water Well 193 Business name License No. Address RR 3 Hutchinson Signed John Danenberg Date 5-10-78 Authorized representative		