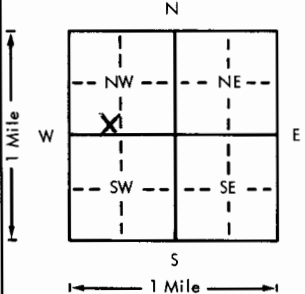
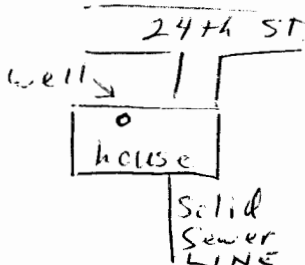


USE TYPEWRITER OR BALL
POINT PEN-PRESS FIRMLY,
PRINT CLEARLY.

WATER WELL RECORD
KSA 82a-1201-1215

Kansas Department of Health and
Environment-Division of Environment
(Water well Contractors)
Topeka, Kansas 66620

1. Location of well:		County Reno	Fraction SE 1/4 SW 1/4 NW 1/4	Section number 2	Township number T 23	Range number S R 6	EW
2. Distance and direction from nearest town or city: Street address of well location if in city:		1305 W. 24th Hutchinson		3. Owner of well: Douglas Dible R.R. or street: 1305 W. 24th City, state, zip code: Hutchinson Kan. 67501			
4. Locate with "X" in section below:		Sketch map:		6. Bore hole dia. 9 in. Completion date 4-23-75 Well depth 28 ft.			
				7. <input type="checkbox"/> Cable tool <input type="checkbox"/> Rotary <input type="checkbox"/> Driven <input checked="" type="checkbox"/> Dug <input type="checkbox"/> Hollow rod <input type="checkbox"/> Jetted <input checked="" type="checkbox"/> Bored <input type="checkbox"/> Reverse rotary			
5. Type and color of material		From		To		8. Use: <input type="checkbox"/> Domestic <input type="checkbox"/> Public supply <input type="checkbox"/> Industry <input type="checkbox"/> Irrigation <input type="checkbox"/> Air conditioning <input type="checkbox"/> Stock <input checked="" type="checkbox"/> Lawn <input type="checkbox"/> Oil field water <input type="checkbox"/> Other	
brown sandy clay		6		9		9. Casing: Material Plas Height: Above or below Threaded <input type="checkbox"/> Welded <input checked="" type="checkbox"/> Surface 12 in. RMP <input checked="" type="checkbox"/> PVC <input type="checkbox"/> Weight <input type="checkbox"/> lbs./ft. Dia. 6 in. to 28 ft. depth Wall Thickness: inches or Dia. <input type="checkbox"/> in. to <input type="checkbox"/> ft. depth gage No. 175	
fine gravel		9		13		10. Screen: Manufacturer's name JAL Type RMP Dia. 6" Slot/gauze 1/8 hole Length 10' Set between 18 ft. and 28 ft. ft. and ft.	
medium gravel		13		28		11. Static water level: 13 ft. below land surface Date 4-23-75 mo./day/yr.	
						12. Pumping level below land surfaces: 13 1/2 ft. after 1 hrs. pumping 30 g.p.m. ft. after hrs. pumping g.p.m. Estimated maximum yield 75 g.p.m.	
						13. Water sample submitted: No mo./day/yr. Yes <input checked="" type="checkbox"/> No <input type="checkbox"/> Date	
						14. Well head completion: 12 Floor Pitless adapter 12 Inches above grade	
						15. Well grouted? yes With: <input type="checkbox"/> Neat cement <input type="checkbox"/> Bentonite <input checked="" type="checkbox"/> Concrete Depth: From 6 ft. to 12 ft. 8' Floor to water	
						16. Nearest source of possible contamination: Solid ft. 25 Direction S Type Sewer Well disinfected upon completion? <input checked="" type="checkbox"/> Yes <input type="checkbox"/> No	
						17. Pump: <input checked="" type="checkbox"/> Not installed Manufacturer's name _____ Model number _____ HP _____ Volts _____ Length of drop pipe _____ ft. capacity _____ g.p.m. Type: <input type="checkbox"/> Submersible <input type="checkbox"/> Turbine <input type="checkbox"/> Jet <input type="checkbox"/> Reciprocating <input type="checkbox"/> Centrifugal <input type="checkbox"/> Other	
18. Elevation:		19. Remarks:		20. Water well contractor's certification:			
Topography: <input type="checkbox"/> Hill <input type="checkbox"/> Slope <input type="checkbox"/> Upland <input checked="" type="checkbox"/> Valley		Well located in basement		This well was drilled under my jurisdiction and this report is true to the best of my knowledge and belief. Price Water Well 193 Business name RR3 Hutchinson License No. _____ Address John Pavenant Date 8-10-77 Signed John Pavenant Authorized representative			