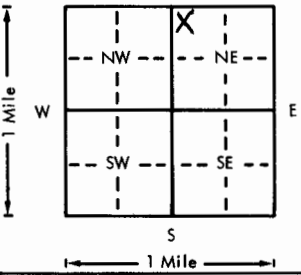
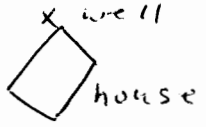


USE TYPEWRITER OR BALL
POINT PEN-PRESS FIRMLY,
PRINT CLEARLY.

WATER WELL RECORD
KSA 82a-1201-1215

Kansas Department of Health and
Environment-Division of Environment
(Water well Contractors)
Topeka, Kansas 66620

1. Location of well:		County <u>Reno</u>	Fraction <u>NW 1/4 NW 1/4 NE 1/4</u>	Section number <u>2</u>	Township number <u>T 23 S R 6 E (W)</u>	Range number <u>6</u>
2. Distance and direction from nearest town or city: Street address of well location if in city: <u>2812 Pamalou Hutchinson Kan</u>				3. Owner of well: <u>William Thomas</u> R.R. or street: <u>2812 Pama Lou</u> City, state, zip code: <u>Hutchinson Kan 67501</u>		
4. Locate with "X" in section below:		Sketch map:		6. Bore hole dia. <u>9</u> in. Completion date <u>12-1-75</u> Well depth <u>34</u> ft.		
				7. Cable tool <input type="checkbox"/> Rotary <input type="checkbox"/> Driven <input checked="" type="checkbox"/> Dug <input type="checkbox"/> Hollow rod <input type="checkbox"/> Jetted <input checked="" type="checkbox"/> Bored <input type="checkbox"/> Reverse rotary		
5. Type and color of material				From	To	8. Use: <input type="checkbox"/> Domestic <input type="checkbox"/> Public supply <input type="checkbox"/> Industry <input type="checkbox"/> Irrigation <input type="checkbox"/> Air conditioning <input type="checkbox"/> Stock <input checked="" type="checkbox"/> Lawn <input type="checkbox"/> Oil field water <input type="checkbox"/> Other
dark brown soil				0	3	9. Casing: Material <u>Plas</u> Height: Above or below Threaded <input type="checkbox"/> Welded <u>Glue</u> Surface <u>12</u> in. RMP <input checked="" type="checkbox"/> PVC <input type="checkbox"/> Weight <u> </u> lbs./ft. Dia. <u>6</u> in. to <u>34</u> ft. depth Wall Thickness: inches or Dia. <u> </u> in. to <u> </u> ft. depth gage No. <u>0.320</u>
brown & grey clay				3	9	10. Screen: Manufacturer's name <u>J & L</u> Type <u>RMP</u> Dia. <u>6"</u> Slot/gauze <u>1/8 hole</u> Length <u>10'</u> Set between <u>24</u> ft. and <u>34</u> ft. <u> </u> ft. and <u> </u> ft. Gravel pack? <u>NO</u> Size range of material <u> </u>
dry medium gravel				9	14	11. Static water level: <u> </u> mo./day/yr. <u>14</u> ft. below land surface Date <u>12-1-75</u>
medium gravel				14	34	12. Pumping level below land surfaces: <u>14</u> ft. after <u>2</u> hrs. pumping <u>20</u> g.p.m. <u> </u> ft. after <u> </u> hrs. pumping <u> </u> g.p.m. Estimated maximum yield <u>50</u> g.p.m.
some clay balls						13. Water sample submitted: <u> </u> mo./day/yr. <u> </u> Yes <input checked="" type="checkbox"/> No <u> </u> Date <u> </u>
						14. Well head completion: <u> </u> Pitless adapter <u>12</u> Inches above grade
						15. Well grouted? <u>yes</u> With: <u> </u> Neat cement <u> </u> Bentonite <input checked="" type="checkbox"/> Concrete Depth: From <u>0</u> ft. to <u>12</u> ft.
						16. Nearest source of possible contamination: ft. <u>20</u> Direction <u>SW</u> Type <u>Sewer</u> Well disinfected upon completion? <input checked="" type="checkbox"/> Yes <u> </u> No
						17. Pump: <input checked="" type="checkbox"/> Not installed Manufacturer's name <u> </u> Model number <u> </u> HP <u> </u> Volts <u> </u> Length of drop pipe <u> </u> ft. capacity <u> </u> g.p.m. Type: <u> </u> Submersible <u> </u> Turbine <u> </u> Jet <u> </u> Reciprocating <u> </u> Centrifugal <u> </u> Other
						20. Water well contractor's certification: This well was drilled under my jurisdiction and this report is true to the best of my knowledge and belief. <u>Price Water Well 193</u> Business name <u>RR #3 Hutchinson Kan</u> License No. <u> </u> Address <u> </u> Signed <u>John Davenport</u> Date <u>5-16-76</u> Authorized representative
18. Elevation:		19. Remarks:				
Topography: <u> </u> Hill <u> </u> Slope <u> </u> Upland <input checked="" type="checkbox"/> Valley						