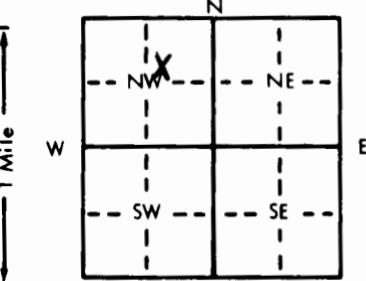


1 LOCATION OF WATER WELL:		Fraction	Section Number	Township Number	Range Number																														
County: <u>Reno</u>		<u>SW 1/4 NE 1/4 NW 1/4</u>	<u>2</u>	<u>T 23 S</u>	<u>R 6 E</u>																														
Distance and direction from nearest town or city street address of well if located within city? <u>1102 Old Farm Dr. Hutchinson</u>																																			
2 WATER WELL OWNER: <u>Don Stiles</u>																																			
RR#, St. Address, Box #: <u>1210 N. Main</u>																																			
City, State, ZIP Code: <u>Hutchinson Kan. 67501</u>																																			
Board of Agriculture, Division of Water Resources Application Number:																																			
3 LOCATE WELL'S LOCATION WITH AN "X" IN SECTION BOX:		4 DEPTH OF COMPLETED WELL: <u>30.7</u> ft. ELEVATION: <u>from basement floor</u>																																	
		Depth(s) Groundwater Encountered 1. <u>12.3</u> ft. 2. <u>from basement floor</u> ft. 3. <u>ft.</u>																																	
		WELL'S STATIC WATER LEVEL <u>18</u> ft. below land surface measured on mo/day/yr <u>5-5-81</u>																																	
		Pump test data: Well water was <u>19</u> ft. after <u>1</u> hours pumping <u>30</u> gpm																																	
		Est. Yield <u>50</u> gpm: Well water was <u>ft.</u> after <u>hours</u> pumping <u>gpm</u>																																	
		Bore Hole Diameter <u>9</u> in. to <u>12</u> ft., and <u>6</u> in. to <u>30</u> ft.																																	
		WELL WATER TO BE USED AS: 5 Public water supply 8 Air conditioning 11 Injection well																																	
		1 Domestic 3 Feedlot 6 Oil field water supply 9 Dewatering 12 Other (Specify below)																																	
		2 Irrigation 4 Industrial <u>9</u> Lawn and garden only 10 Observation well																																	
		Was a chemical/bacteriological sample submitted to Department? Yes <u>No</u> <u>X</u> ; If yes, mo/day/yr sample was submitted <u>Water Well Disinfected? Yes X No</u>																																	
5 TYPE OF BLANK CASING USED:																																			
1 Steel 3 RMP (SR) 5 Wrought iron 8 Concrete tile CASING JOINTS: Glued <u>X</u> Clamped																																			
<u>2</u> PVC 4 ABS 6 Asbestos-Cement 9 Other (specify below) Welded																																			
7 Fiberglass Threaded																																			
Blank casing diameter <u>6</u> in. to <u>20</u> ft., Dia <u>in.</u> to <u>ft.</u> , Dia <u>in.</u> to <u>ft.</u>																																			
Casing height above land surface <u>12</u> in., weight <u>lbs./ft.</u> Wall thickness or gauge No. <u>12.55</u>																																			
TYPE OF SCREEN OR PERFORATION MATERIAL: <u>1</u> PVC 10 Asbestos-cement																																			
1 Steel 3 Stainless steel 5 Fiberglass 8 RMP (SR) 11 Other (specify)																																			
2 Brass 4 Galvanized steel 6 Concrete tile 9 ABS 12 None used (open hole)																																			
SCREEN OR PERFORATION OPENINGS ARE: 5 Gauzed wrapped 8 Saw cut 11 None (open hole)																																			
1 Continuous slot 3 Mill slot 6 Wire wrapped <u>9</u> Drilled holes																																			
2 Louvered shutter 4 Key punched 7 Torch cut 10 Other (specify)																																			
SCREEN-PERFORATED INTERVALS: From <u>20</u> ft. to <u>30</u> ft., From <u>ft.</u> to <u>ft.</u>																																			
GRAVEL PACK INTERVALS: From <u>ft.</u> to <u>ft.</u> , From <u>ft.</u> to <u>ft.</u>																																			
6 GROUT MATERIAL: 1 Neat cement <u>2</u> Cement grout 3 Bentonite 4 Other																																			
Grout Intervals: From <u>1</u> ft. to <u>11</u> ft., From <u>ft.</u> to <u>ft.</u>																																			
What is the nearest source of possible contamination: 10 Livestock pens 14 Abandoned water well																																			
1 Septic tank 4 Lateral lines 7 Pit privy 11 Fuel storage 15 Oil well/Gas well																																			
2 Sewer lines 5 Cess pool 8 Sewage lagoon 12 Fertilizer storage 16 Other (specify below)																																			
<u>3</u> Watertight sewer lines 6 Seepage pit 9 Feedyard 13 Insecticide storage																																			
Direction from well? <u>South</u> How many feet? <u>30</u>																																			
<table border="1"><thead><tr><th>FROM</th><th>TO</th><th>LITHOLOGIC LOG</th><th>FROM</th><th>TO</th><th>LITHOLOGIC LOG</th></tr></thead><tbody><tr><td><u>0</u></td><td><u>4</u></td><td><u>Sandy brown clay</u></td><td></td><td></td><td></td></tr><tr><td><u>4</u></td><td><u>7</u></td><td><u>fine sand</u></td><td></td><td></td><td></td></tr><tr><td><u>7</u></td><td><u>13</u></td><td><u>fine gravel</u></td><td></td><td></td><td></td></tr><tr><td><u>13</u></td><td><u>30</u></td><td><u>medium gravel</u></td><td></td><td></td><td></td></tr>
7 CONTRACTOR'S OR LANDOWNER'S CERTIFICATION: This water well was <u>X</u> constructed, (2) reconstructed, or (3) plugged under my jurisdiction and was completed on (mo/day/year) <u>5-5-81</u> and this record is true to the best of my knowledge and belief. Kansas Water Well Contractor's License No. <u>193</u> This Water Well Record was completed on (mo/day/yr) <u>6-20-82</u> under the business name of <u>Price Water Well Service</u> by (signature) <u>John Davenport</u>																																			
INSTRUCTIONS: Use typewriter or ball point pen, PLEASE PRESS FIRMLY and PRINT clearly. Please fill in blanks, underline or circle the correct answers. Send top three copies to Kansas Department of Health and Environment, Division of Environment, Environmental Geology Section, Topeka, KS 66620. Send one to WATER WELL OWNER and retain one for your records.																																			