


1 LOCATION OF WATER WELL:		Fraction	Section Number	Township Number	Range Number
County: Reno	NE 1/4 NW 1/4 SE 1/4	3	T 23 S	R 6 E/W	

Distance and direction from nearest town or city street address of well if located within city?

1613 W. 22nd.

2	WATER WELL OWNER:	Mr. Billy Cortner	
	RR#, St. Address, Box # :	1613 West 22nd	Board of Agriculture, Division of Water Resources
	City, State, ZIP Code :	Hutchinson, KS 67501	Application Number:

3 LOCATE WELL'S LOCATION WITH AN "X" IN SECTION BOX: 4 DEPTH OF COMPLETED WELL: 40 ft. ELEVATION:

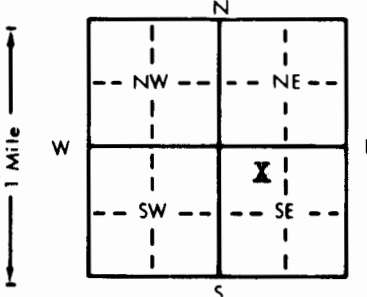

4 DEPTH OF COMPLETED WELL..... 40 ft. ELEVATION:
 Depth(s) Groundwater Encountered 1. 7 ft. 2. ft. 3. ft.
 WELL'S STATIC WATER LEVEL .. 8 ft. below land surface measured on mo/day/yr 8/6/82
NO Pump test data: Well water was ft. after hours pumping gpm
 Est. Yield gpm: Well water was ft. after hours pumping gpm
 Bore Hole Diameter 10 in. to 40 ft., and in. to ft.
 WELL WATER TO BE USED AS: 5 Public water supply 8 Air conditioning 11 Injection well
 1 Domestic 3 Feedlot 6 Oil field water supply 9 Dewatering 12 Other (Specify below)
 2 Irrigation 4 Industrial 7 Lawn and garden only 10 Observation well
 Was a chemical/bacteriological sample submitted to Department? Yes.....No. **X**.....; If yes, mo/day/yr sample was sub-
 mitted Water Well Disinfected? Yes No **X**.....

5	TYPE OF BLANK CASING USED:		5 Wrought iron	8 Concrete tile	CASING JOINTS: Glued ☒ Clamped Welded Threaded
	1 Steel	3 RMP (SR)	6 Asbestos-Cement	9 Other (specify below)	
	2 PVC	4 ABS	7 Fiberglass		

Blank casing diameter 5 in. to 0-20 ft. Dia. in. to ft. Dia. in. to ft.
Casing height above land surface 18 in. weight 160 lbs./ft. Wall thickness or gauge No. .216

TYPE OF SCREEN OR PERFORATION MATERIAL:			7 PVC	10 Asbestos-cement
1 Steel	3 Stainless steel	5 Fiberglass	<u>8 RMP (SR)</u>	11 Other (specify)
2 Brass	4 Galvanized steel	6 Concrete tile	9 ABS	12 None used (open hole)

SCREEN OR PERFORATION OPENINGS ARE:		5 Gauzed wrapped	<u>8 Saw cut</u>	11 None (open hole)
1 Continuous slot	3 Mill slot	6 Wire wrapped	9 Drilled holes	
2 Louvered shutter	4 Key punched	7 Torch cut	10 Other (specify)	

SCREEN-PERFORATED INTERVALS:	From	20	ft. to	40	ft., From	ft. to	ft.
	From		ft. to		ft., From	ft. to	ft.
GRAVEL PACK INTERVALS:	From	8	ft. to	40	ft., From	ft. to	ft.
	From		ft. to		ft., From	ft. to	ft.

6 GROUT MATERIAL: 1 Neat cement 2 Cement grout 3 Bentonite 4 Other

Grout Intervals: From 0 ft. to 8 ft. From ft. to ft. From ft. to ft.

What is the nearest source of possible contamination:

1 Septic tank	4 Lateral lines	7 Pit privy	10 Livestock pens	14 Abandoned water well
2 Sewer lines	5 Cess pool	8 Sewage lagoon	11 Fuel storage	15 Oil well/Gas well
3 Watertight sewer lines	6 Seepage pit	9 Feedyard	12 Fertilizer storage	16 Other (specify below)
			13 Insecticide storage	NONE

[illegible]

7 CONTRACTOR'S OR LANDOWNER'S CERTIFICATION: This water well was (1) constructed, (2) reconstructed, or (3) plugged under my jurisdiction and was completed on (mo/day/year) 8/6/82 and this record is true to the best of my knowledge and belief. Kansas Water Well Contractor's License No. DL34 This Water Well Record was completed on (mo/day/yr) 8/9/82 under the business name of Rosencrantz-Bemis Ent. by (signature) Diane [Signature]

INSTRUCTIONS: Use typewriter or ball point pen, ***PLEASE PRESS FIRMLY*** and ***PRINT*** clearly. Please fill in blanks, underline or circle the correct answers. Send top three copies to Kansas Department of Health and Environment, Division of Environment, Environmental Geology Section, Topeka, KS 66620. Send one to WATER WELL OWNER and retain one for your records.