


1 LOCATION OF WATER WELL:	Fraction	Section Number	Township Number	Range Number
County: <u>Reno</u>	<u>SE 1/4 SE 1/4 SE 1/4</u>	<u>3</u>	<u>T 23 S</u>	<u>R 6 E/W</u>

Distance and direction from nearest town or city street address of well if located within city?

1513 W. 18th Hutchinson Kan.

2 WATER WELL OWNER:	Board of Agriculture, Division of Water Resources
RR#, St. Address, Box # : <u>1513 W. 18th</u>	Application Number:
City, State, ZIP Code : <u>Hutchinson Kan 67502</u>	

3 LOCATE WELL'S LOCATION WITH AN "X" IN SECTION BOX:	4 DEPTH OF COMPLETED WELL: <u>35</u> ft. ELEVATION:
--	---

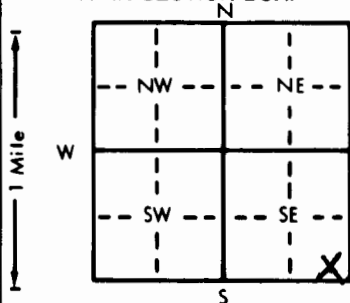

Depth(s) Groundwater Encountered <u>14</u> ft.	2. <u>14</u> ft.	3. <u>7-27-88</u> ft.
WELL'S STATIC WATER LEVEL <u>14</u> ft. below land surface measured on mo/day/yr		
Pump test data: Well water was <u>15</u> ft. after <u>1</u> hours pumping		<u>25</u> gpm
Est. Yield <u>75</u> gpm. Well water was <u>15</u> ft. after <u>6</u> hours pumping		<u>35</u> gpm
Bore Hole Diameter <u>9</u> in. to <u>15</u> ft., and <u>6</u> in. to <u>35</u> ft.		
WELL WATER TO BE USED AS:	5 Public water supply	8 Air conditioning
<u>1</u> Domestic	3 Feedlot	6 Oil field water supply
2 Irrigation	4 Industrial	7 Lawn and garden only
		10 Observation well
Was a chemical/bacteriological sample submitted to Department? Yes <u>X</u> No <u>X</u>		If yes, mo/day/yr sample was submitted
	Water Well Disinfected? Yes <u>X</u> No <u>X</u>	

5 TYPE OF BLANK CASING USED:	5 Wrought iron	8 Concrete tile	CASING JOINTS: Glued <u>X</u> Clamped
<u>1</u> Steel	3 RMP (SR)	6 Asbestos-Cement	9 Other (specify below)
<u>2</u> PVC	4 ABS	7 Fiberglass	Welded
Blank casing diameter <u>6</u> in. to <u>25</u> ft., Dia			Threaded
Casing height above land surface <u>12</u> in., weight			lbs./ft. Wall thickness or gauge No. <u>250</u>
TYPE OF SCREEN OR PERFORATION MATERIAL:			
<u>1</u> Steel	3 Stainless steel	5 Fiberglass	8 RMP (SR)
2 Brass	4 Galvanized steel	6 Concrete tile	9 ABS
SCREEN OR PERFORATION OPENINGS ARE:			
<u>1</u> Continuous slot	<u>3</u> Mill slot	5 Gauzed wrapped	8 Saw cut
2 Louvered shutter	4 Key punched	6 Wire wrapped	9 Drilled holes
		7 Torch cut	10 Other (specify)
SCREEN-PERFORATED INTERVALS:	From <u>25</u> ft. to <u>35</u> ft.		
	From <u>25</u> ft. to <u>35</u> ft.		
GRAVEL PACK INTERVALS:	From <u>25</u> ft. to <u>35</u> ft.		
	From <u>25</u> ft. to <u>35</u> ft.		

6 GROUT MATERIAL:	<u>1</u> Neat cement	2 Cement grout	3 Bentonite	4 Other
Grout Intervals: From <u>3</u> ft. to <u>15</u> ft.				
What is the nearest source of possible contamination:				
<u>1</u> Septic tank	4 Lateral lines	7 Pit privy	10 Livestock pens	14 Abandoned water well
2 Sewer lines	5 Cess pool	8 Sewage lagoon	11 Fuel storage	15 Oil well/Gas well
<u>3</u> Watertight sewer lines	6 Seepage pit	9 Feedyard	12 Fertilizer storage	16 Other (specify below)
Direction from well? <u>West</u>				
				How many feet? <u>40</u>

FROM	TO	LITHOLOGIC LOG	FROM	TO	LITHOLOGIC LOG
<u>0</u>	<u>2</u>	<u>brown soil</u>			
<u>2</u>	<u>7</u>	<u>sandy clay</u>			
<u>7</u>	<u>11</u>	<u>clay</u>			
<u>11</u>	<u>14</u>	<u>fine sand</u>			
<u>14</u>	<u>35</u>	<u>fine gravel</u>			
		<u>medium gravel</u>			

7 CONTRACTOR'S OR LANDOWNER'S CERTIFICATION: This water well was <u>1</u> constructed, (2) reconstructed, or (3) plugged under my jurisdiction and was completed on (mo/day/year) <u>7-27-88</u> and this record is true to the best of my knowledge and belief. Kansas Water Well Contractor's License No. <u>193</u> This Water Well Record was completed on (mo/day/yr) <u>6-20-89</u> under the business name of <u>Price Water Well Serv.</u> by (signature) <u>John Davenport</u>

INSTRUCTIONS: Use typewriter or ball point pen. PLEASE PRESS FIRMLY and PRINT clearly. Please fill in blanks, underline or circle the correct answers. Send top three copies to Kansas Department of Health and Environment, Bureau of Water Protection, Topeka, Kansas 66620-7320, Telephone: 913-862-9360. Send one to WATER WELL OWNER and retain one for your records.