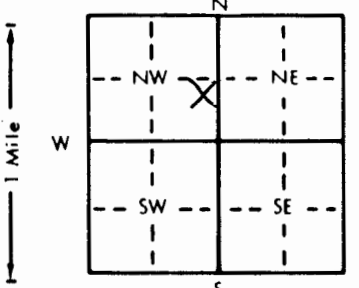


<b>1 LOCATION OF WATER WELL:</b>		Fraction		Section Number		Township Number		Range Number	
County: <b>Reno</b>		NE 1/4 SE 1/4 NW 1/4		3		T 23 S		R 6 EW	
Distance and direction from nearest town or city street address of well if located within city? <b>124 West 4th Street, Hutchinson, Ks.</b>									
<b>2 WATER WELL OWNER:</b>		<b>T &amp; E Oil #17</b>		Board of Agriculture, Division of Water Resources					
RR#, St. Address, Box # :		<b>P.O. Box 1303</b>		Application Number:					
City, State, ZIP Code		<b>Hutchinson, Ks. 67504</b>							
<b>3 LOCATE WELL'S LOCATION WITH AN "X" IN SECTION BOX:</b>		<b>4 DEPTH OF COMPLETED WELL: 18 ft. ELEVATION: NA</b>							
		Depth(s) Groundwater Encountered 1. <b>10</b> ft. 2. ft. 3. ft.							
		WELL'S STATIC WATER LEVEL <b>10.92</b> ft. below land surface measured on mo/day/yr <b>03-14-94</b>							
		Pump test data: Well water was ft. after hours pumping gpm							
		Est. Yield gpm: Well water was ft. after hours pumping gpm							
Bore Hole Diameter <b>7 5/8</b> in. to <b>18</b> ft., and in. to ft.		WELL WATER TO BE USED AS:							
1 Domestic		3 Feedlot		6 Oil field water supply		9 Dewatering		12 Other (Specify below)	
2 Irrigation		4 Industrial		7 Lawn and garden only		10 Monitoring well			
Was a chemical/bacteriological sample submitted to Department? Yes No <b>X</b> ; If yes, mo/day/yr sample was submitted									
Water Well Disinfected? Yes No <b>X</b>									
<b>5 TYPE OF BLANK CASING USED:</b>									
1 Steel		3 RMP (SR)		5 Wrought iron		8 Concrete tile		CASING JOINTS: Glued Clamped	
<b>2 PVC</b>		4 ABS		6 Asbestos-Cement		9 Other (specify below)		Welded	
				7 Fiberglass				Threaded <b>X</b>	
Blank casing diameter <b>2</b> in. to <b>8</b> ft., Dia in. to ft., Dia in. to ft.									
Casing height above land surface <b>0</b> in., weight lbs./ft. Wall thickness or gauge No. <b>sch. 40</b>									
TYPE OF SCREEN OR PERFORATION MATERIAL:									
1 Steel		3 Stainless steel		5 Fiberglass		<b>7 PVC</b>		10 Asbestos-cement	
2 Brass		4 Galvanized steel		6 Concrete tile		8 RMP (SR)		11 Other (specify)	
						9 ABS		12 None used (open hole)	
SCREEN OR PERFORATION OPENINGS ARE:									
1 Continuous slot		<b>3 Mill slot</b>		5 Gauzed wrapped		8 Saw cut		11 None (open hole)	
2 Louvered shutter		4 Key punched		6 Wire wrapped		9 Drilled holes			
				7 Torch cut		10 Other (specify)			
SCREEN-PERFORATED INTERVALS: From <b>8</b> ft. to <b>18</b> ft., From ft. to ft.									
GRAVEL PACK INTERVALS: From <b>7</b> ft. to <b>18</b> ft., From ft. to ft.									
<b>6 GROUT MATERIAL:</b>									
1 Neat cement		<b>2 Cement grout</b>		<b>3 Bentonite</b>		4 Other			
Grout Intervals: From <b>0</b> ft. to <b>5</b> ft., From <b>5</b> ft. to <b>7</b> ft., From ft. to ft.									
What is the nearest source of possible contamination:									
1 Septic tank		4 Lateral lines		7 Pit privy		<b>11 Fuel storage</b>		14 Abandoned water well	
2 Sewer lines		5 Cess pool		8 Sewage lagoon		12 Fertilizer storage		15 Oil well/Gas well	
3 Watertight sewer lines		6 Seepage pit		9 Feedyard		13 Insecticide storage		16 Other (specify below)	
Direction from well? <b>west</b>									
How many feet? <b>200</b>									
FROM		TO		LITHOLOGIC LOG		FROM		TO	
0		1		cly, mod brn, v sndy, v slty, moist					
1		4		cly, v dk brn, mod sndy, mod slty, moist					
4		7		snd, lt brn, f-c w/tr grvl, p srted, damp					
7		15		snd, lt brn, f-vc w/mod f-c grvl, p srted, damp-sat					
15		18		snd, mod-dk gry, f-v c w/mod f-c grvl, p srted, damp-sat					
MW9-flush mount cover									
Site ID 65885									
<b>7 CONTRACTOR'S OR LANDOWNER'S CERTIFICATION:</b> This water well was <b>(1)</b> constructed, (2) reconstructed, or (3) plugged under my jurisdiction and was completed on (mo/day/year) <b>03-04-94</b> and this record is true to the best of my knowledge and belief. Kansas Water Well Contractor's License No. <b>527</b> This Water Well Record was completed on (mo/day/yr) <b>03-17-94</b> under the business name of <b>GeoCore Services, Inc.</b> by (signature) <i>Dale Rolf</i>									