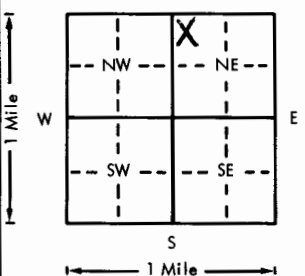
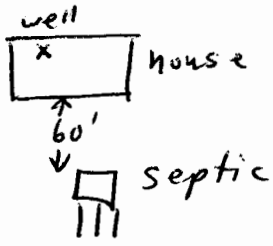


USE TYPEWRITER OR BALL
POINT PEN-PRESS FIRMLY,
PRINT CLEARLY.

WATER WELL RECORD
KSA 82a-1201-1215

Kansas Department of Health and
Environment-Division of Environment
(Water well Contractors)
Topeka, Kansas 66620

1. Location of well:		County Reno	Fraction NW 1/4 NW 1/4 NE 1/4	Section number 4	Township number T 23 S	Range number R 6 E
2. Distance and direction from nearest town or city: Street address of well location if in city:		3405 Homestead Hutchinson Kan.		3. Owner of well: Elmer Smith R.R. or street: RR #1 City, state, zip code: Nickerson Kan.		
4. Locate with "X" in section below:		Sketch map:		6. Bore hole dia. 9 in. Completion date 12-9-75 Well depth 40 ft.		
				7. Cable tool <input type="checkbox"/> Rotary <input type="checkbox"/> Driven <input checked="" type="checkbox"/> Dug <input type="checkbox"/> Hollow rod <input type="checkbox"/> Jetted <input checked="" type="checkbox"/> Bored <input type="checkbox"/> Reverse rotary		
5. Type and color of material		From		To		8. Use: <input checked="" type="checkbox"/> Domestic <input type="checkbox"/> Public supply <input type="checkbox"/> Industry <input type="checkbox"/> Irrigation <input type="checkbox"/> Air conditioning <input type="checkbox"/> Stock <input type="checkbox"/> Lawn <input type="checkbox"/> Oil field water <input type="checkbox"/> Other
Soil & Sandy Clay		0		3		9. Casing: Material Plas Height: Above or below Threaded <input type="checkbox"/> Welded 6 1/2 Surface 12 in. RMP <input checked="" type="checkbox"/> PVC <input type="checkbox"/> Weight <input type="checkbox"/> lbs./ft. Dia. 6 in. to 40 ft. depth Wall Thickness: inches or Dia. <input type="checkbox"/> in. to <input type="checkbox"/> ft. depth gage No. 320
Sandy clay & sand		3		5		10. Screen: Manufacturer's name J & L Type RMP Dia. 6" Slot/gauze 1/8 hole Length 10' Set between 30 ft. and 40 ft. ft. and ft. Gravel pack? No Size range of material
fine sand		5		7		11. Static water level: <input type="checkbox"/> mo./day/yr. 7 ft. below land surface Date 12-9-75
& gravel						12. Pumping level below land surfaces: ft. after hrs. pumping g.p.m. ft. after hrs. pumping g.p.m. Estimated maximum yield 75 g.p.m.
medium gravel		7		40		13. Water sample submitted: <input type="checkbox"/> mo./day/yr. Yes <input checked="" type="checkbox"/> No Date
with clay balls						14. Well head completion: Pitless adapter 12 inches above grade
						15. Well grouted? yes With: <input checked="" type="checkbox"/> Neat cement <input type="checkbox"/> Bentonite <input checked="" type="checkbox"/> Concrete Depth: From 0 ft. to 8 ft.
						16. Nearest source of possible contamination: ft. 60 Direction South Type Septic Well disinfected upon completion? <input checked="" type="checkbox"/> Yes <input checked="" type="checkbox"/> No
						17. Pump: <input checked="" type="checkbox"/> Not installed Manufacturer's name Model number HP Volts Length of drop pipe ft. capacity g.p.m. Type: <input type="checkbox"/> Submersible <input type="checkbox"/> Turbine <input type="checkbox"/> Jet <input type="checkbox"/> Reciprocating <input type="checkbox"/> Centrifugal <input type="checkbox"/> Other
						20. Water well contractor's certification: This well was drilled under my jurisdiction and this report is true to the best of my knowledge and belief. Price Water Well 193 Business name License No. Address RR #3 Hutchinson Signed John Pavey Date 6-16-76 Authorized representative
18. Elevation:		19. Remarks:				
Topography: <input type="checkbox"/> Hill <input type="checkbox"/> Slope <input type="checkbox"/> Upland <input checked="" type="checkbox"/> Valley						