USE TYPEWRITER OR BALL POINT PEN-PRESS FIRMLY, PRINT CLEARLY.

WATER WELL RECORD
KSA 82a-1201-1215

Kansas Department of Health and Environment-Division of Environment
(Water well Contractors)
Topeka, Kansas 66620

1. Location of well:	County	Fraction	Section number	Township number	Range number
	Reno	NW¼ NW¼ NE¼	4	T 23 S	R 6 E (W)

2. Distance and direction from nearest town or city: 3406 Homestead
Street address of well location if in city: Hutchinson

3. Owner of well: Phillip Fairbanks
R.R. or street: 815 W 13th
City, state, zip code: Hutchinson Kan. 67501

4. Locate with "X" in section below:

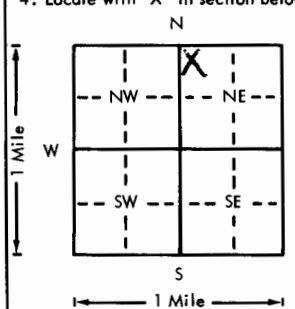

Sketch map:

6. Bore hole dia. 9 in. Completion date
Well depth 40 ft. 1-5-76

7. __ Cable tool __ Rotary __ Driven X Dug
__ Hollow rod __ Jetted X Bored __ Reverse rotary

8. Use: X Domestic __ Public supply __ Industry
__ Irrigation __ Air conditioning __ Stock
__ Lawn __ Oil field water __ Other

9. Casing: Material Plas Height: Above or below
Threaded ___ Welded Glue Surface 12 in.
RMP X PVC ___ Weight ___ lbs./ft.
Dia. 6 in. to 40 ft. depth Wall Thickness: inches or
Dia. ___ in. to ___ ft. depth gage No. 320

5. Type and color of material	From	To
Soil & sandy clay	0	3
fine sand	3	6
medium gravel	6	40

(Use a second sheet if needed)

10. Screen: Manufacturer's name J & L
Type RMP Dia. 6"
Slot/gauze 1/8 hole Length 10'
Set between 30 ft. and 40 ft.
___ ft. and ___ ft.
Gravel pack? NO Size range of material

11. Static water level: mo./day/yr.
7 ft. below land surface Date 1-5-76

12. Pumping level below land surfaces:
___ ft. after ___ hrs. pumping ___ g.p.m.
___ ft. after ___ hrs. pumping ___ g.p.m.
Estimated maximum yield 75 g.p.m.

13. Water sample submitted: mo./day/yr.
___ Yes X No Date

14. Well head completion:
___ Pitless adapter 12 Inches above grade

15. Well grouted? yes
With: X Neat cement ___ Bentonite ___ Concrete
Depth: From 0 ft. to 8 ft.

16. Nearest source of possible contamination:
ft. 50 Direction N Type Septic
Well disinfected upon completion? X Yes ___ No

17. Pump: X Not installed
Manufacturer's name
Model number HP Volts
Length of drop pipe ft. capacity g.p.m.
Type:
___ Submersible ___ Turbine
___ Jet ___ Reciprocating
___ Centrifugal ___ Other

18. Elevation:

Topography:
___ Hill
___ Slope
___ Upland
X Valley

19. Remarks:

20. Water well contractor's certification:
This well was drilled under my jurisdiction and this report is true to the best of my knowledge and belief.
Price Water Well 193
Business name License No.
Address RR#3 Hutchinson
Signed John Davenport Date 6-15-76
Authorized representative

T 23 — R 6 (W) — Sec 4 — 1/4 NW 1/4 NW 1/4 NE

Forward the white, blue and pink copies to the Department of Health and Environment

Form WWC-5