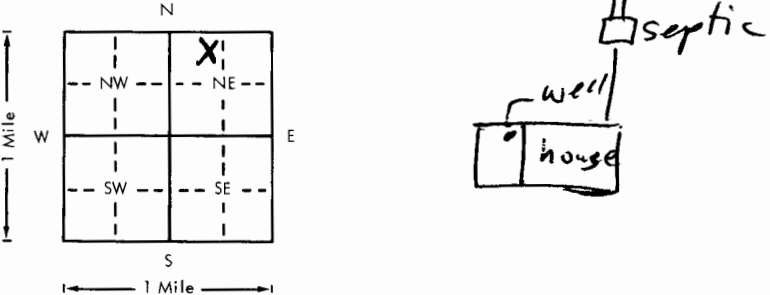


USE TYPEWRITER OR BALL  
POINT PEN-PRESS FIRMLY,  
PRINT CLEARLY.

WATER WELL RECORD  
KSA 82a-1201-1215

Kansas Department of Health and  
Environment-Division of Environment  
(Water well Contractors)  
Topeka, Kansas 66620

1. Location of well:		County <b>Reno</b>	Fraction <b>NE 1/4 NW 1/4 NE 1/4</b>	Section number <b>4</b>	Township number <b>T 23 S</b>	Range number <b>R 6 E</b>
2. Distance and direction from nearest town or city: Street address of well location if in city:		<b>3104 Homestead Hutchinson</b>		3. Owner of well: R.R. or street: City, state, zip code:		
4. Locate with "X" in section below:		Sketch map:		6. Bore hole dia. <u>9</u> in. Completion date <u>12-2-77</u> Well depth <u>38</u> ft.		
				7. <input type="checkbox"/> Cable tool <input type="checkbox"/> Rotary <input type="checkbox"/> Driven <input checked="" type="checkbox"/> Dug <input type="checkbox"/> Hollow rod <input type="checkbox"/> Jetted <input checked="" type="checkbox"/> Bored <input type="checkbox"/> Reverse rotary		
5. Type and color of material		From		To		8. Use: <input checked="" type="checkbox"/> Domestic <input type="checkbox"/> Public supply <input type="checkbox"/> Industry <input type="checkbox"/> Irrigation <input type="checkbox"/> Air conditioning <input type="checkbox"/> Stock <input type="checkbox"/> Lawn <input type="checkbox"/> Oil field water <input type="checkbox"/> Other
brown sandy soil		0		3		9. Casing: Material <u>Plas</u> Height: Above or below Threading <u>Welded</u> Surface <u>12</u> in. RMP <input checked="" type="checkbox"/> PVC <input type="checkbox"/> Weight <u>12</u> lbs./ft.
brown sandy clay		3		5		Dia. <u>6</u> in. to <u>38</u> ft. depth Wall Thickness: inches or Dia. <u>6</u> in. to <u>38</u> ft. depth gage No. <u>1175</u>
fine sand		5		8		10. Screen: Manufacturer's name <u>J&amp;L</u> Type <u>RMP</u> Dia. <u>6"</u> Slot/gauze <u>1/8 hole</u> Length <u>10'</u> Set between <u>28</u> ft. and <u>38</u> ft. Gravel pack? <u>No</u> Size range of material <u>        </u>
fine gravel		8		11		11. Static water level: <u>8</u> ft. below land surface Date <u>12-2-77</u> mo./day/yr.
medium gravel		11		38		12. Pumping level below land surfaces: <u>8 1/2</u> ft. after <u>1</u> hrs. pumping <u>20</u> g.p.m. ft. after <u>        </u> hrs. pumping <u>        </u> g.p.m. Estimated maximum yield <u>75</u> g.p.m.
						13. Water sample submitted: <u>        </u> mo./day/yr. <u>        </u> Yes <input checked="" type="checkbox"/> No <input type="checkbox"/> Date <u>        </u>
						14. Well head completion: <u>        </u> Pitless adapter <u>12</u> inches above grade
						15. Well grouted? <u>yes</u> With: <input checked="" type="checkbox"/> Neat cement <input type="checkbox"/> Bentonite <input type="checkbox"/> Concrete Depth: From <u>3</u> ft. to <u>9</u> ft.
						16. Nearest source of possible contamination: ft. <u>55</u> Direction <u>NE</u> Type <u>septic</u> Well disinfected upon completion? <input checked="" type="checkbox"/> Yes <input type="checkbox"/> No
						17. Pump: <input checked="" type="checkbox"/> Not installed Manufacturer's name <u>        </u> Model number <u>        </u> HP <u>        </u> Volts <u>        </u> Length of drop pipe <u>        </u> ft. capacity <u>        </u> g.p.m. Type: <input type="checkbox"/> Submersible <input type="checkbox"/> Turbine <input type="checkbox"/> Jet <input type="checkbox"/> Reciprocating <input type="checkbox"/> Centrifugal <input type="checkbox"/> Other
18. Elevation:		19. Remarks:		20. Water well contractor's certification:		
Topography: <input type="checkbox"/> Hill <input type="checkbox"/> Slope <input type="checkbox"/> Upland <input checked="" type="checkbox"/> Valley		<u>well in garage</u>		This well was drilled under my jurisdiction and this report is true to the best of my knowledge and belief. <u>Price Water Well 193</u> Business name <u>RR3 Hutchinson</u> License No. <u>        </u> Address <u>        </u> Signed <u>John Dawson</u> Date <u>6/1/78</u> Authorized representative		

2-3-4  
T-3-4  
R-60  
Sec 4  
1/4 1/4 1/4