
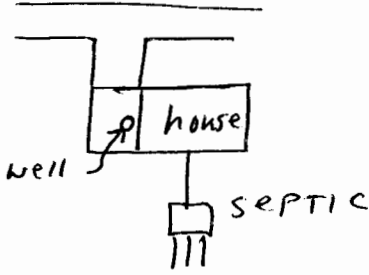


USE TYPEWRITER OR BALL
POINT PEN-PRESS FIRMLY,
PRINT CLEARLY.

WATER WELL RECORD
KSA 82a-1201-1215

Kansas Department of Health and
Environment-Division of Environment
(Water well Contractors)
Topeka, Kansas 66620

✓ 1. Location of well:	County <u>Reno</u>	Fraction <u>SE 1/4 NW 1/4 NE 1/4</u>	Section number <u>4</u>	Township number <u>T 23 S</u>	Range number <u>R 6 E</u>
2. Distance and direction from nearest town or city: Street address of well location if in city:		3. Owner of well: R.R. or street: City, state, zip code:			
<u>3315 Homestead</u> <u>Hutchinson</u>		<u>George Friesen</u> <u>3315 Homestead</u> <u>Hutchinson Kan. 67501</u>			
4. Locate with "X" in section below: N W E S 1 Mile 1 Mile		Sketch map: 		6. Bore hole dia. <u>9</u> in. Completion date <u>5-3-76</u> Well depth <u>40</u> ft.	
5. Type and color of material		From	To	7. <input type="checkbox"/> Cable tool <input type="checkbox"/> Rotary <input type="checkbox"/> Driven <input checked="" type="checkbox"/> Dug <input type="checkbox"/> Hollow rod <input type="checkbox"/> Jetted <input checked="" type="checkbox"/> Bored <input type="checkbox"/> Reverse rotary	
<u>Sandy top soil</u>		<u>0</u>	<u>3</u>	8. Use: <input checked="" type="checkbox"/> Domestic <input type="checkbox"/> Public supply <input type="checkbox"/> Industry <input type="checkbox"/> Irrigation <input type="checkbox"/> Air conditioning <input type="checkbox"/> Stock <input type="checkbox"/> Lawn <input type="checkbox"/> Oil field water <input type="checkbox"/> Other	
<u>brown sandy clay</u>		<u>3</u>	<u>5</u>	9. Casing: Material <u>Plas</u> Height: Above or below Threaded <input type="checkbox"/> Welded <u>Glue</u> Surface <u>12</u> in. RMP <input checked="" type="checkbox"/> PVC <input type="checkbox"/> Weight <input type="checkbox"/> lbs./ft. Dia. <u>6</u> in. to <u>40</u> ft. depth Wall Thickness: inches or Dia. <input type="checkbox"/> in. to <input type="checkbox"/> ft. depth gage No. <u>1175</u>	
<u>fine gravel</u>		<u>5</u>	<u>7</u>	10. Screen: Manufacturer's name <u>J & L</u> Type <u>RMP</u> Dia. <u>6"</u> Slot/gauze <u>Whole</u> Length <u>10'</u> Set between <u>30</u> ft. and <u>40</u> ft. ft. and ft. Gravel pack? <u>No</u> Size range of material	
<u>medium gravel</u>		<u>7</u>	<u>40</u>	11. Static water level: <u>8</u> ft. below land surface Date <u>5-3-76</u> mo./day/yr	
				12. Pumping level below land surfaces: <u>8 1/2</u> ft. after <u>1</u> hrs. pumping <u>25</u> g.p.m. ft. after hrs. pumping g.p.m. Estimated maximum yield <u>75</u> g.p.m.	
				13. Water sample submitted: mo./day/yr Yes <input checked="" type="checkbox"/> No <input type="checkbox"/> Date	
				14. Well head completion: Pitless adapter <u>12</u> Inches above grade	
				15. Well grouted? <u>yes</u> With: <input checked="" type="checkbox"/> Neat cement <input type="checkbox"/> Bentonite <input type="checkbox"/> Concrete Depth: From <u>1</u> ft. to <u>9</u> ft.	
				16. Nearest source of possible contamination: ft. <u>60</u> Direction <u>SE</u> Type <u>Septic</u> Well disinfected upon completion? <input checked="" type="checkbox"/> Yes <input type="checkbox"/> No	
				17. Pump: <input checked="" type="checkbox"/> Not installed Manufacturer's name Model number HP Volts Length of drop pipe ft. capacity g.p.m. Type: <input type="checkbox"/> Submersible <input type="checkbox"/> Turbine <input type="checkbox"/> Jet <input type="checkbox"/> Reciprocating <input type="checkbox"/> Centrifugal <input type="checkbox"/> Other	
18. Elevation:		19. Remarks:		20. Water well contractor's certification: This well was drilled under my jurisdiction and this report is true to the best of my knowledge and belief. <u>Price Water Well 193</u> Business name License No. Address <u>RR3 Hutchinson</u> Signed <u>John Davenport</u> Date <u>8-7-77</u> Authorized representative	
Topography: <input type="checkbox"/> Hill <input type="checkbox"/> Slope <input checked="" type="checkbox"/> Upland <input checked="" type="checkbox"/> Valley		<u>Well located in garage</u>			

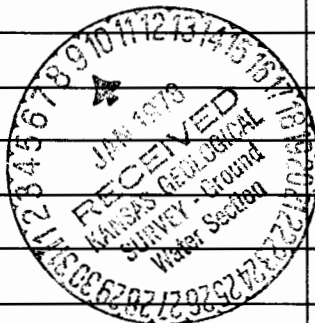

(Use a second sheet if needed)