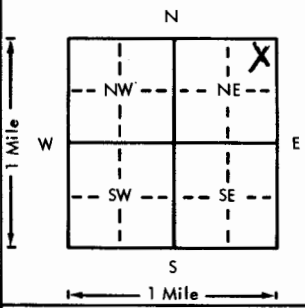
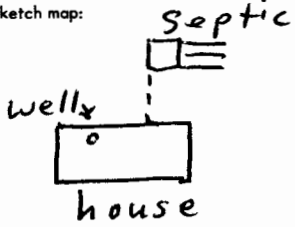


USE TYPEWRITER OR BALL  
POINT PEN-PRESS FIRMLY,  
PRINT CLEARLY.

WATER WELL RECORD  
KSA 82a-1201-1215

Kansas Department of Health and  
Environment-Division of Environment  
(Water well Contractors)  
Topeka, Kansas 66620

1. Location of well:		County <b>Reno</b>	Fraction <b>NE 1/4 NE 1/4 NE 1/4</b>	Section number <b>4</b>	Township number <b>T 23 S</b>	Range number <b>R 6 E</b>
2. Distance and direction from nearest town or city: Street address of well location if in city:		<b>3110 Homestead Hutchinson Kan</b>		3. Owner of well: R.R. or street: City, state, zip code: <b>Fairbanks Const. 815 W. 13th Hutchinson, Kan 67501</b>		
4. Locate with "X" in section below: 		Sketch map: 		6. Bore hole dia. <b>9</b> in. Completion date Well depth <b>40</b> ft. <b>3-22-77</b>		
5. Type and color of material		From		To		7. <input type="checkbox"/> Cable tool <input type="checkbox"/> Rotary <input type="checkbox"/> Driven <input type="checkbox"/> Dug <input type="checkbox"/> Hollow rod <input type="checkbox"/> Jetted <input checked="" type="checkbox"/> Bored <input type="checkbox"/> Reverse rotary
Sandy top soil		0		2		8. Use: <input checked="" type="checkbox"/> Domestic <input type="checkbox"/> Public supply <input type="checkbox"/> Industry <input type="checkbox"/> Irrigation <input type="checkbox"/> Air conditioning <input type="checkbox"/> Stock <input checked="" type="checkbox"/> Lawn <input type="checkbox"/> Oil field water <input type="checkbox"/> Other
Sandy clay		2		6		9. Casing: Material <b>Plas</b> Height: <b>above</b> or below Threaded <input type="checkbox"/> Welded <b>6 in</b> Surface <b>12</b> in. RMP <input checked="" type="checkbox"/> PVC <input type="checkbox"/> Weight <input type="checkbox"/> lbs./ft.
fine gravel		6		8		Dia. <b>6</b> in. to <b>40</b> ft. depth Wall Thickness: inches or Dia. <input type="checkbox"/> in. to <input type="checkbox"/> ft. depth gauge No. <b>1172</b>
medium gravel		8		40		10. Screen: Manufacturer's name <b>J &amp; L</b> Type <b>RMP</b> Dia. <b>6"</b> Slot/gauze <b>1/8 hole</b> Length <b>10'</b> Set between <b>30</b> ft. and <b>40</b> ft. Gravel pack? <b>NO</b> Size range of material <input type="checkbox"/>
						11. Static water level: <b>7</b> ft. below land surface Date <b>3-22-77</b> mo./day/yr.
						12. Pumping level below land surfaces: <b>7 1/2</b> ft. after <b>2</b> hrs. pumping <b>15</b> g.p.m. ft. after <input type="checkbox"/> hrs. pumping <input type="checkbox"/> g.p.m. Estimated maximum yield <b>50</b> g.p.m.
						13. Water sample submitted: <input type="checkbox"/> Yes <input checked="" type="checkbox"/> No Date <input type="checkbox"/> mo./day/yr.
						14. Well head completion: <input type="checkbox"/> Pitless adapter <b>12</b> inches above grade
						15. Well grouted? <b>yes</b> With: <input checked="" type="checkbox"/> Neat cement <input type="checkbox"/> Bentonite <input type="checkbox"/> Concrete Depth: From <b>0</b> ft. to <b>8</b> ft.
						16. Nearest source of possible contamination: ft. <b>60</b> Direction <b>NE</b> Type <b>Septic</b> Well disinfected upon completion? <input checked="" type="checkbox"/> Yes <input type="checkbox"/> No
						17. Pump: <input checked="" type="checkbox"/> Not installed Manufacturer's name <input type="checkbox"/> Model number <input type="checkbox"/> HP <input type="checkbox"/> Volts <input type="checkbox"/> Length of drop pipe <input type="checkbox"/> ft. capacity <input type="checkbox"/> g.p.m. Type: <input type="checkbox"/> Submersible <input type="checkbox"/> Turbine <input type="checkbox"/> Jet <input type="checkbox"/> Reciprocating <input type="checkbox"/> Centrifugal <input type="checkbox"/> Other
						20. Water well contractor's certification: This well was drilled under my jurisdiction and this report is true to the best of my knowledge and belief. <b>Price Water Well 193</b> Business name <b>RR3 Hutchinson</b> License No. <input type="checkbox"/> Address <b>John Davenport</b> Date <b>5-20-77</b> Signed <b>John Davenport</b> Authorized representative
18. Elevation:		19. Remarks:				
Topography: <input type="checkbox"/> Hill <input type="checkbox"/> Slope <input type="checkbox"/> Upland <input checked="" type="checkbox"/> Valley						