


1 LOCATION OF WATER WELL: County: <b>Reno</b>	Fraction <b>SW 1/4 NE 1/4 NE 1/4</b>	Section Number <b>4</b>	Township Number <b>T 23 S</b>	Range Number <b>R 6 E</b>
--	---	----------------------------	----------------------------------	------------------------------

Distance and direction from nearest town or city street address of well if located within city?

**3206 Sycamore Rd Hutchinson Kan**

2 WATER WELL OWNER: RR#, St. Address, Box # : City, State, ZIP Code	<b>Bruce Nichols</b> <b>3206 Sycamore Rd</b> <b>Hutchinson Kan 67802</b>	Board of Agriculture, Division of Water Resources Application Number:
---	--	--

3 LOCATE WELL'S LOCATION WITH AN "X" IN SECTION BOX:	4 DEPTH OF COMPLETED WELL: <b>36</b> ft. ELEVATION:
--	---

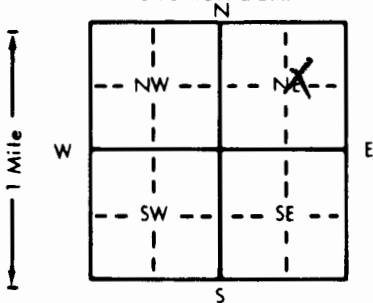

Depth(s) Groundwater Encountered 1. ft. 2. ft. 3. ft.

WELL'S STATIC WATER LEVEL **8** ft. below land surface measured on mo/day/yr **5-9-94**

Pump test data: Well water was ft. after hours pumping gpm

Est. Yield gpm: Well water was ft. after hours pumping gpm

Bore Hole Diameter in. to ft., and in. to ft.

WELL WATER TO BE USED AS:

5 Public water supply	8 Air conditioning	11 Injection well
1 Domestic	3 Feedlot	6 Oil field water supply
2 Irrigation	4 Industrial	7 Lawn and garden only
		10 Monitoring well

Was a chemical/bacteriological sample submitted to Department? Yes No **X** If yes, mo/day/yr sample was submittedWater Well Disinfected? Yes **X** No

5 TYPE OF BLANK CASING USED:	5 Wrought iron	8 Concrete tile	CASING JOINTS: Glued <b>X</b> Clamped
1 Steel	3 RMP (SR)	6 Asbestos-Cement	9 Other (specify below)
2 PVC	4 ABS	7 Fiberglass	Welded
Blank casing diameter in. Dia	48		Threaded

Casing height above land surface in., weight lbs./ft. Wall thickness or gauge No.

TYPE OF SCREEN OR PERFORATION MATERIAL:

1 Steel	3 Stainless steel	5 Fiberglass	8 RMP (SR)	11 Other (specify) <b>NA</b>
2 Brass	4 Galvanized steel	6 Concrete tile	9 ABS	12 None used (open hole)

SCREEN OR PERFORATION OPENINGS ARE:

1 Continuous slot	3 Mill slot	5 Gauzed wrapped	8 Saw cut	11 None (open hole)
2 Louvered shutter	4 Key punched	6 Wire wrapped	9 Drilled holes	
		7 Torch cut	10 Other (specify) <b>NA</b>	

SCREEN-PERFORATED INTERVALS: From ft. to ft. From ft. to ft. From ft. to ft. From ft. to ft.

GRAVEL PACK INTERVALS: From ft. to ft. From ft. to ft. From ft. to ft. From ft. to ft.

6 GROUT MATERIAL:	1 Neat cement	2 Cement grout	3 Bentonite	4 Other
Grout Intervals: From ft. to ft. From ft. to ft. From ft. to ft. From ft. to ft.	<b>0</b>	<b>4</b>	<b>6</b>	<b>9</b>

What is the nearest source of possible contamination:

1 Septic tank	4 Lateral lines	7 Pit privy	10 Livestock pens	14 Abandoned water well
2 Sewer lines	5 Cess pool	8 Sewage lagoon	11 Fuel storage	15 Oil well/Gas well
3 Watertight sewer lines	6 Seepage pit	9 Feedyard	12 Fertilizer storage	16 Other (specify below)
			13 Insecticide storage	

Direction from well? **North** How many feet? **50**

FROM	TO	LITHOLOGIC LOG	FROM	TO	PLUGGING INTERVALS
			<b>0</b>	<b>4</b>	<b>cement grout</b>
			<b>4</b>	<b>6</b>	<b>chlorinated gravel</b>
			<b>6</b>	<b>9</b>	<b>cement grout</b>
			<b>9</b>	<b>36</b>	<b>chlorinated gravel</b>

7 CONTRACTOR'S OR LANDOWNER'S CERTIFICATION: This water well was (1) constructed, (2) reconstructed, or (3) plugged under my jurisdiction and was completed on (mo/day/year) <b>5-9-94</b> and this record is true to the best of my knowledge and belief. Kansas Water Well Contractor's License No. <b>193</b> This Water Well Record was completed on (mo/day/yr) <b>5-9-94</b> under the business name of <b>Price Water Well Serv.</b> by (signature) <b>John Davenport</b>
--