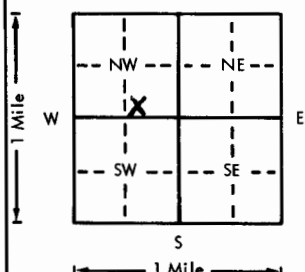


USE TYPEWRITER OR BALL
POINT PEN-PRESS FIRMLY,
PRINT CLEARLY.

WATER WELL RECORD
KSA 82a-1201-1215

Kansas Department of Health and
Environment-Division of Environment
(Water well Contractors)
Topeka, Kansas 66620

1. Location of well:		County <u>Reno</u>	Fraction <u>SW 1/4 SE 1/4 NW 1/4</u>	Section number <u>9</u>	Township number <u>T 23 S</u>	Range number <u>R 6 E</u>
2. Distance and direction from nearest town or city: Street address of well location if in city: <u>3802 W. 7th Hutchinson</u>				3. Owner of well: <u>North American Inv.</u> R.R. or street: <u>201 N. White side</u> City, state, zip code: <u>Hutchinson Kan. 67501</u>		
4. Locate with "X" in section below: 				6. Bore hole dia. <u>7</u> in. Completion date <u>5-26-77</u> Well depth <u>35</u> ft.		
5. Type and color of material				7. <input type="checkbox"/> Cable tool <input type="checkbox"/> Rotary <input checked="" type="checkbox"/> Driven <input checked="" type="checkbox"/> Dug <input type="checkbox"/> Hollow rod <input checked="" type="checkbox"/> Jetted <input type="checkbox"/> Bored <input type="checkbox"/> Reverse rotary		
				8. Use: <input checked="" type="checkbox"/> Domestic <input type="checkbox"/> Public supply <input type="checkbox"/> Industry <input type="checkbox"/> Irrigation <input type="checkbox"/> Air conditioning <input type="checkbox"/> Stock <input type="checkbox"/> Lawn <input type="checkbox"/> Oil field water <input type="checkbox"/> Other		
				9. Casing: Material <u>PVC</u> Height: <u>Above</u> or below Threaded <input type="checkbox"/> Welded <u>Blue</u> Surface <u>12</u> in. RMP <input checked="" type="checkbox"/> PVC <input type="checkbox"/> Weight <input type="checkbox"/> lbs./ft. Dia. <u>6</u> in. to <u>35</u> ft. depth Wall Thickness: inches or Dia. <input type="checkbox"/> in. to <input type="checkbox"/> ft. depth Gage No. <u>175</u>		
				10. Screen: Manufacturer's name <u>J&L</u> Type <u>RMP</u> Dia. <u>6"</u> Slot/gauze <u>1/8 hole</u> Length <u>10'</u> Set between <u>25</u> ft. and <u>35</u> ft. Gravel pack? <u>NO</u> Size range of material <input type="checkbox"/>		
				11. Static water level: <u>10</u> ft. below land surface Date <u>5-26-77</u> mo./day/yr.		
				12. Pumping level below land surfaces: <u>10 1/2</u> ft. after <u>1</u> hrs. pumping <u>15</u> g.p.m. ft. after <u> </u> hrs. pumping <u> </u> g.p.m. Estimated maximum yield <u>50</u> g.p.m.		
				13. Water sample submitted: <u> </u> mo./day/yr. Yes <input checked="" type="checkbox"/> No <input type="checkbox"/> Date <u> </u>		
				14. Well head completion: <input checked="" type="checkbox"/> Pitless adapter <u>12</u> inches above grade		
				15. Well grouted? <u>yes</u> With: <input checked="" type="checkbox"/> Neat cement <input type="checkbox"/> Bentonite <input type="checkbox"/> Concrete Depth: From <u>3</u> ft. to <u>11</u> ft.		
				16. Nearest source of possible contamination: ft. <u>60</u> Direction <u>NW</u> Type <u>septic</u> Well disinfected upon completion? <input checked="" type="checkbox"/> Yes <input type="checkbox"/> No		
				17. Pump: Not installed Manufacturer's name <u>STA RITE</u> Model number <u>Ser 8</u> HP <u>1/2</u> Volts <u>230</u> Length of drop pipe <u>20</u> ft. capacity <u>15</u> g.p.m. Type: <input checked="" type="checkbox"/> Submersible <input type="checkbox"/> Turbine <input type="checkbox"/> Jet <input type="checkbox"/> Reciprocating <input type="checkbox"/> Centrifugal <input type="checkbox"/> Other		
(Use a second sheet if needed)						
18. Elevation:		19. Remarks:				
Topography: <input type="checkbox"/> Hill <input type="checkbox"/> Slope <input type="checkbox"/> Upland <input checked="" type="checkbox"/> Valley						
20. Water well contractor's certification: This well was drilled under my jurisdiction and this report is true to the best of my knowledge and belief. <u>Price Water Well 193</u> Business name <u>PR3 Hutchinson</u> License No. <u> </u> Address <u> </u> Signed <u>John Parnoy</u> Date <u>7-20-77</u> Authorized representative						