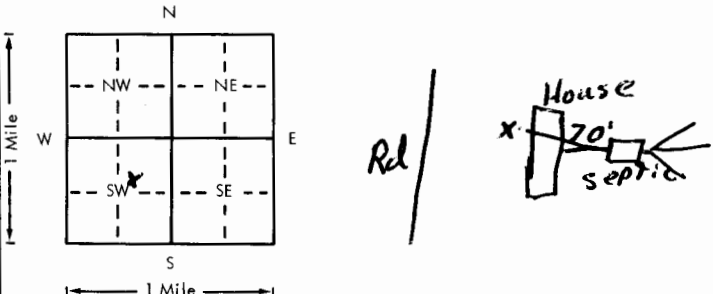


USE TYPEWRITER OR BALL
POINT PEN-PRESS FIRMLY,
PRINT CLEARLY.

WATER WELL RECORD
KSA 82a-1201-1215

Kansas Department of Health and
Environment-Division of Environment
(Water well Contractors)
Topeka, Kansas 66620

1. Location of well:		County Reno	Fraction SW 1/4 NE 1/4 SW 1/4	Section number 9	Township number T 23	Range number S R 6 E
2. Distance and direction from nearest town or city: Street address of well location if in city: 3608 W 7th				3. Owner of well: Dean Lewis R.R. or street: 3608 W 7th City, state, zip code: Hutchinson, KS 67501		
4. Locate with "X" in section below:		Sketch map:		6. Bore hole dia. 10 in. Completion date 6-9-78 Well depth 29 ft. 228		
				7. <input checked="" type="checkbox"/> Cable tool <input checked="" type="checkbox"/> Rotary <input type="checkbox"/> Driven <input type="checkbox"/> Dug <input type="checkbox"/> Hollow rod <input type="checkbox"/> Jetted <input type="checkbox"/> Bored <input type="checkbox"/> Reverse rotary		
5. Type and color of material		From		To		8. Use: <input checked="" type="checkbox"/> Domestic <input type="checkbox"/> Public supply <input type="checkbox"/> Industry <input type="checkbox"/> Irrigation <input type="checkbox"/> Air conditioning <input type="checkbox"/> Stock <input type="checkbox"/> Lawn <input type="checkbox"/> Oil field water <input type="checkbox"/> Other
Sandy top soil		0		8		9. Casing: Material Plst Height: Above or below Threaded <input type="checkbox"/> Welded <input type="checkbox"/> Surface 14 in. RMP <input checked="" type="checkbox"/> PVC <input type="checkbox"/> Weight 1.95 lbs./ft. Dia. 6 in. to 29 ft. depth Wall Thickness: inches or Dia. <input type="checkbox"/> in. to <input type="checkbox"/> ft. depth gage No. 200
Sand + gravel		8		35		10. Screen: Manufacturer's name Sunflower Type RMP Dia. 6 Slot/gauze 1030 Length 10 Set between 19 ft. and 29 ft. <input type="checkbox"/> ft. and <input type="checkbox"/> ft. Gravel pack? Yes Size range of material E-1/2
						11. Static water level: <input type="checkbox"/> mo./day/yr. 8 ft. below land surface Date 6-9-78
						12. Pumping level below land surfaces: 9 ft. after 1 hrs. pumping 25 g.p.m. <input type="checkbox"/> ft. after <input type="checkbox"/> hrs. pumping <input type="checkbox"/> g.p.m. Estimated maximum yield 50 g.p.m.
						13. Water sample submitted: <input type="checkbox"/> Yes <input checked="" type="checkbox"/> No Date <input type="checkbox"/>
						14. Well head completion: <input checked="" type="checkbox"/> Pitless adapter <input type="checkbox"/> Inches above grade
						15. Well grouted? Yes With: <input checked="" type="checkbox"/> Neat cement <input type="checkbox"/> Bentonite <input type="checkbox"/> Concrete Depth: From 3 ft. to 10 ft.
						16. Nearest source of possible contamination: ft. 70 Direction E Type Septic Well disinfected upon completion? <input checked="" type="checkbox"/> Yes <input type="checkbox"/> No
						17. Pump: <input type="checkbox"/> Not installed Manufacturer's name Valley Steel Model number 51206 HP 1/3 Volts 220 Length of drop pipe 15 ft. capacity 12 g.p.m. Type: <input checked="" type="checkbox"/> Submersible <input type="checkbox"/> Turbine <input type="checkbox"/> Jet <input type="checkbox"/> Reciprocating <input type="checkbox"/> Centrifugal <input type="checkbox"/> Other
						20. Water well contractor's certification: This well was drilled under my jurisdiction and this report is true to the best of my knowledge and belief. Miller Water Well 137 Business name License No. Address Hutchinson, KS Signed C. Miller Date 6-24-78 Authorized representative
18. Elevation:		19. Remarks:				
Topography: <input type="checkbox"/> Hill <input type="checkbox"/> Slope <input type="checkbox"/> Upland <input checked="" type="checkbox"/> Valley						

23-60-9
T
R
Sec
1/4 1/4 1/4
SW NE SE