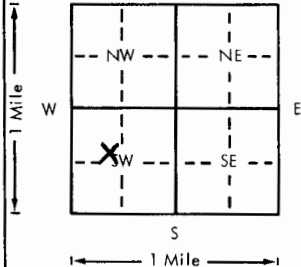


USE TYPEWRITER OR BALL
POINT PEN-PRESS FIRMLY,
PRINT CLEARLY.

WATER WELL RECORD
KSA 82a-1201-1215

Kansas Department of Health and
Environment-Division of Environment
(Water well Contractors)
Topeka, Kansas 66620

1. Location of well:		County Reno	Fraction SE 1/4 NW 1/4 SW 1/4	Section number 9	Township number T 23 S R 6 E/W	Range number 6
2. Distance and direction from nearest town or city: 3809 W. 7th Street address of well location if in city: Hutchinson				3. Owner of well: Lyle Hawver R.R. or street: 3809 W 7th City, state, zip code: Hutchinson Kan 67501		
4. Locate with "X" in section below:		Sketch map:		6. Bore hole dia. 7 in. Completion date Well depth 35 ft. 8-12-77		
				7. <input type="checkbox"/> Cable tool <input type="checkbox"/> Rotary <input type="checkbox"/> Driven <input checked="" type="checkbox"/> Dug <input type="checkbox"/> Hollow rod <input type="checkbox"/> Jetted <input checked="" type="checkbox"/> Bored <input type="checkbox"/> Reverse rotary		
5. Type and color of material				From	To	8. Use: <input checked="" type="checkbox"/> Domestic <input type="checkbox"/> Public supply <input type="checkbox"/> Industry <input type="checkbox"/> Irrigation <input type="checkbox"/> Air conditioning <input type="checkbox"/> Stock <input type="checkbox"/> Lawn <input type="checkbox"/> Oil field water <input type="checkbox"/> Other
brown sandy soil				0	3	9. Casing: Material Plas Height: Above or below Threaded <input type="checkbox"/> Welded 64 Surface 12 in. RMP <input checked="" type="checkbox"/> PVC <input type="checkbox"/> Weight <input type="checkbox"/> lbs./ft. Dia. 6 in. to 35 ft. depth Wall Thickness: inches or Dia. <input type="checkbox"/> in. to <input type="checkbox"/> ft. depth gage No. 1175
brown sandy clay				3	7	10. Screen: Manufacturer's name J&L
fine sand				7	9	Type RMP Dia. 6" Slot/gauze 1/8 hole Length 10' Set between 35 ft. and 35 ft. ft. and <input type="checkbox"/> ft.
fine gravel				9	11	Gravel pack? NO Size range of material <input type="checkbox"/>
medium gravel				11	35	11. Static water level: <input type="checkbox"/> mo./day/yr. 9 ft. below land surface Date 8-12-77
						12. Pumping level below land surfaces: 9 1/2 ft. after 1 hrs. pumping 15 g.p.m. <input type="checkbox"/> ft. after <input type="checkbox"/> hrs. pumping <input type="checkbox"/> g.p.m. Estimated maximum yield 75 g.p.m.
						13. Water sample submitted: <input type="checkbox"/> mo./day/yr. <input type="checkbox"/> Yes <input checked="" type="checkbox"/> No Date <input type="checkbox"/>
						14. Well head completion: <input checked="" type="checkbox"/> Pitless adapter 12 Inches above grade
						15. Well grouted? yes With: <input checked="" type="checkbox"/> Neat cement <input type="checkbox"/> Bentonite <input type="checkbox"/> Concrete Depth: From 3 ft. to 10 ft.
						16. Nearest source of possible contamination: ft. 55 Direction SW Type Septic Well disinfected upon completion? <input checked="" type="checkbox"/> Yes <input type="checkbox"/> No
						17. Pump: <input type="checkbox"/> Not installed Manufacturer's name STA-RITE Model number Ser 8 HP 1/2 Volts 230 Length of drop pipe 25 ft. capacity 12 g.p.m. Type: <input checked="" type="checkbox"/> Submersible <input type="checkbox"/> Turbine <input type="checkbox"/> Jet <input type="checkbox"/> Reciprocating <input type="checkbox"/> Centrifugal <input type="checkbox"/> Other
(Use a second sheet if needed)						
18. Elevation:		19. Remarks:		20. Water well contractor's certification: This well was drilled under my jurisdiction and this report is true to the best of my knowledge and belief. Price Water Well 193 Business name RR3 Hutchinson License No. 6-25-78 Address John Davenport Date 6-25-78 Signed John Davenport Authorized representative		
Topography: <input type="checkbox"/> Hill <input type="checkbox"/> Slope <input type="checkbox"/> Upland <input checked="" type="checkbox"/> Valley						

23 - 60W - 9 SE 1/4 1/4 1/4 1/4