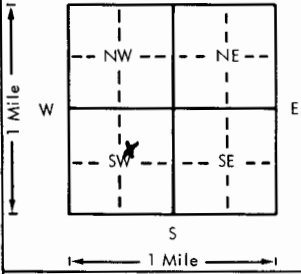
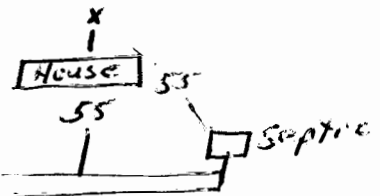


USE TYPEWRITER OR BALL  
POINT PEN-PRESS FIRMLY,  
PRINT CLEARLY.

WATER WELL RECORD  
KSA 82a-1201-1215

Kansas Department of Health and  
Environment-Division of Environment  
(Water well Contractors)  
Topeka, Kansas 66620

1. Location of well:		County <b>Reno</b>	Fraction <b>SW 1/4 NE 1/4 SW 1/4</b>	Section number <b>9</b>	Township number <b>T 23</b>	Range number <b>S 6 R 6</b>	<b>EW</b>
2. Distance and direction from nearest town or city: <b>2 mi. w of</b>				3. Owner of well: <b>N. A. I. C.</b>			
Street address of well location if in city: <b>3609 W 9th Hutch.</b>				R.R. or street: <b>201 N Whiteside</b>			
				City, state, zip code: <b>Hutchinson, KS 67501</b>			
4. Locate with "X" in section below:		Sketch map:		6. Bore hole dia. <b>Note</b> in. Completion date <b>7-14-79</b>			
				Well depth <b>30</b> ft.			
				7. <input checked="" type="checkbox"/> Cable tool <input checked="" type="checkbox"/> Rotary <input type="checkbox"/> Driven <input type="checkbox"/> Dug <input type="checkbox"/> Hollow rod <input type="checkbox"/> Jetted <input type="checkbox"/> Bored <input type="checkbox"/> Reverse rotary			
				8. Use: <input checked="" type="checkbox"/> Domestic <input type="checkbox"/> Public supply <input type="checkbox"/> Industry <input type="checkbox"/> Irrigation <input type="checkbox"/> Air conditioning <input type="checkbox"/> Stock <input type="checkbox"/> Lawn <input type="checkbox"/> Oil field water <input type="checkbox"/> Other			
				9. Casing: Material <b>Plst</b> Height: <b>above</b> or below Threaded <input type="checkbox"/> Welded <input type="checkbox"/> Surface <b>12</b> in. RMP <input checked="" type="checkbox"/> PVC <input type="checkbox"/> Weight <b>1.35</b> lbs./ft. Dia. <b>6</b> in. to <b>30</b> ft. depth Wall Thickness: inches or Dia. <input type="checkbox"/> in. to <input type="checkbox"/> ft. depth gage No. <b>100</b>			
5. Type and color of material		From		To		10. Screen: Manufacturer's name <b>J+L</b>	
<b>Black Sandy Silt</b>		<b>0</b>		<b>6</b>		Type <b>RMP</b> Dia. <b>6</b>	
<b>Sand + gravel</b>		<b>6</b>		<b>35</b>		Slot/gauze <b>10.35</b> Length <b>10'</b>	
						Set between <b>20</b> ft. and <b>30</b> ft.	
						Gravel pack? <b>Yes</b> Size range of material <b>F-1/2</b>	
						11. Static water level: <b>9</b> ft. below land surface Date <b>7-14-79</b>	
						12. Pumping level below land surfaces: <b>11</b> ft. after <b>2</b> hrs. pumping <b>20</b> g.p.m. ft. after <input type="checkbox"/> hrs. pumping <input type="checkbox"/> g.p.m. Estimated maximum yield <b>50</b> g.p.m.	
						13. Water sample submitted: <input type="checkbox"/> Yes <input checked="" type="checkbox"/> No Date <input type="checkbox"/>	
						14. Well head completion: <input checked="" type="checkbox"/> Pitless adapter <input type="checkbox"/> Inches above grade	
						15. Well grouted? <b>Yes</b> With: <input checked="" type="checkbox"/> Neat cement <input type="checkbox"/> Bentonite <input type="checkbox"/> Concrete Depth: From <b>3</b> ft. to <b>11</b> ft.	
						16. Nearest source of possible contamination: ft. <b>55</b> Direction <b>S</b> Type <b>septic</b> Well disinfected upon completion? <input checked="" type="checkbox"/> Yes <input type="checkbox"/> No	
						17. Pump: <input type="checkbox"/> Not installed Manufacturer's name <b>Valley Pump</b> Model number <b>51206</b> HP <b>1/2</b> Volts <b>230</b> Length of drop pipe <b>16</b> ft. capacity <b>12</b> g.p.m. Type: <input checked="" type="checkbox"/> Submersible <input type="checkbox"/> Turbine <input type="checkbox"/> Jet <input type="checkbox"/> Reciprocating <input type="checkbox"/> Centrifugal <input type="checkbox"/> Other	
18. Elevation:		19. Remarks:		20. Water well contractor's certification:			
Topography: <input type="checkbox"/> Hill <input type="checkbox"/> Slope <input type="checkbox"/> Upland <input checked="" type="checkbox"/> Valley		<b>10" to 12'</b> <b>8' From 12' to 35'</b>		This well was drilled under my jurisdiction and this report is true to the best of my knowledge and belief. <b>Miller Water well 382</b> Business name <b>Hutch, KS</b> License No. <input type="checkbox"/> Address <b>Hutch, KS</b> Signed <b>Egan Miller</b> Date <b>8-5-79</b> Authorized representative			